

Wilkinson
 T 15
 12-30-69

MISSISSIPPI
 BOARD OF WATER COMMISSIONERS
 416 North State Street
 Jackson, Mississippi 39201

CODED

WATER WELL DRILLERS LOG

December 30 1969 Griner Water Well Co. Wilkinson
 date well completed firm name county well located

LANDOWNER:
 Daniel Ashburnet
 Centerville, Miss.
 (mailing address)

description of formations encountered	from	to
Top soil	0	1
fine gravel		
clay	1	3
sand	3	50
Gravel	50	170

WELL LOCATION:
 sec. 15 T-1 N S R-1 E W
 3 miles SW of Centerville
 (distance) (direction) (nearest town)

WELL PURPOSE: Home
 (home, irrigation, municipal, industrial)

- WELL COMPLETION DATA:**
- (1) diameter (inches) 2"
 - (2) total depth (feet) 120'
 - (3) static water level (feet) 100' below above top of ground.
 - (4) casing Galv. (material), 113' (depth)
 2" (size) if telescope see back.
 - (5) screen 5' (length), 113' (depth to top)
 2" (size), 5.5 (material)
 - (6) pump 1 (HP), 10 (yield gpm)
electric (type power)
 - (7) electric log no (yes or no)

(organization running log)

(8) how well bottom plugged wood plug


DRILLERS REMARKS:

JAN 20 1970

MISS. BD. OF WATER COMM.

If well telescopes please sketch and show depths.

GROUND LEVEL

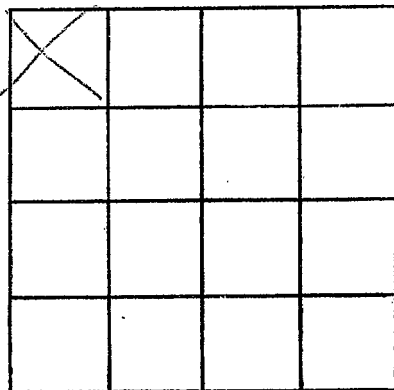

SECTION 15

Please indicate well location X.

ADDITIONAL INFORMATION

If more than one screen,
show locations of each on sketch.