

WILKERSON
T 18
3-15-71

MISSISSIPPI
BOARD OF WATER COMMISSIONERS
416 North State Street
Jackson, Mississippi 39201

CODED

WATER WELL DRILLERS LOG

3-15 1971 *Flynn Well Dr* *Waltham*
date well completed firm name county well located

LANDOWNER:
J.W. Brown
RR Centreville, Miss
(mailing address)

description of formations encountered	from	to
<i>Red clay</i>	<i>0</i>	<i>20</i>
<i>white clay</i>	<i>20</i>	<i>30</i>
<i>limestone</i>	<i>30</i>	<i>101</i>

WELL LOCATION:
sec. *6* T. *1* N. S. R. *1* E. W.
2 miles *SW* of *Centreville*
(distance) (direction) (nearest town)

WELL PURPOSE:
Home
(home, irrigation, municipal, industrial)

- WELL COMPLETION DATA:
- (1) diameter (inches) *4*
 - (2) total depth (feet) *101*
 - (3) static water level (feet) *50* below above top of ground.
 - (4) casing *plastic* *95*
(material) (depth)
4 if telescope see back.
(size)
 - (5) screen *6* *95*
(length) (depth to top)
4 *plastic*
(size) (material)
 - (6) pump *1/2* *10*
(HP) (yield gpm)
elc
(type power)
 - (7) electric log *no*
(yes or no)
(organization running log)
 - (8) how well bottom plugged *decently*


CODED

MAR 31 1971

DRILLERS REMARKS:

If well telescopes please sketch and show depths.

GROUND LEVEL

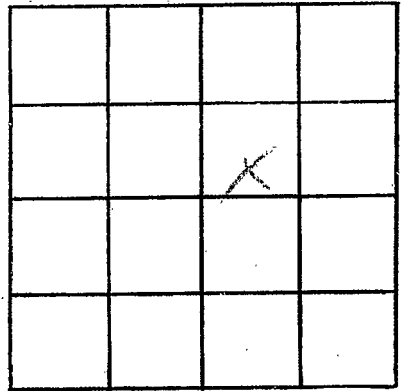

SECTION 6

Please indicate well location X.

ADDITIONAL INFORMATION

If more than one screen, show locations of each on sketch.