

**WILKINSON**  
**T 19**  
**6-3-72**

79  
**MISSISSIPPI**  
**BOARD OF WATER COMMISSIONERS**  
 416 North State Street  
 Jackson, Mississippi 39201

**WATER WELL DRILLERS LOG**

June 3 1972 Chester Kelms Wilkinson  
 date well completed firm name county well located

LANDOWNER: James Jones  
RFD  
Centerville  
 (mailing address)

description of formations encountered	from	to
Red Clay	0	16
Red sand	16	64
Coarse sand & gravel	64	81

WELL LOCATION:  
 sec. 49 T L N S R 1 E W  
5 1/4 miles S Centerville  
 (distance) (direction) (nearest town)

WELL PURPOSE: Drain  
 (home, irrigation, municipal, industrial)

- WELL COMPLETION DATA:
- (1) diameter (inches) 4"
  - (2) total depth (feet) 81
  - (3) static water level (feet) 60 below top of ground.
  - (4) casing Plastic (material) bottom (depth)
  - \_\_\_\_\_ if telescope see back. (size)
  - (5) screen 6' (length) 75' (depth to top)
  - 4" (size) Plastic (material)
  - (6) pump 1/2 HP (HP) 15 (yield gpm)
  - Electric (type power)
  - (7) electric log No (yes or no)

\_\_\_\_\_ (organization running log)

(8) how well bottom plugged. wooden plug.


DRILLERS/REMARKS: Red well not adequate.

JUNE 30 1972

MISS. ED. C.  
 WATER COM.

If well telescopes please sketch and show depths.

GROUND LEVEL

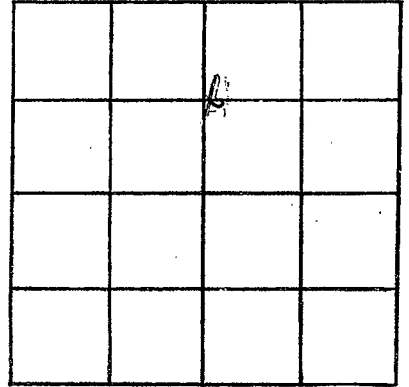

SECTION 49

Please indicate well location X.

ADDITIONAL INFORMATION

If more than one screen,  
show locations of each on sketch.