

WILKINSON
T 21
12-15-72

MISSISSIPPI
BOARD OF WATER COMMISSIONERS
416 North State Street
Jackson, Mississippi 39201

CODED

WATER WELL DRILLERS LOG


12-15 1972 General Water Works, Wilkinson
date well completed firm name county well located

| LANDOWNER: | description of formations encountered | from | to |
|---|---------------------------------------|------|----|
| T. L. James Centerville Miss. (mailing address) | | | |
| WELL LOCATION: | | | |
| sec. <u>2</u> T <u>1</u> N <u>5</u> R <u>1</u> E <u>W</u> <u>1</u> miles <u>S</u> of <u>Centerville</u> (distance) (direction) (nearest town) | | | |
| WELL PURPOSE: <u>industrial</u> (home, irrigation, municipal, industrial) | | | |
| WELL COMPLETION DATA: | | | |
| (1) diameter (inches) <u>4"</u> | | | |
| (2) total depth (feet) <u>189'</u> | | | |
| (3) static water level (feet) <u>86'</u> below top of ground. | | | |
| (4) casing <u>Galv.</u> <u>179'</u> (material) (depth) <u>4"</u> if telescope see back. (size) | | | |
| (5) screen <u>10'</u> <u>179'</u> (length) (depth to top) <u>4"</u> <u>55'</u> (size) (material) | | | |
| (6) pump <u>5</u> (HP) (yield gpm) <u>elec.</u> (type power) | | | |
| (7) electric log <u>no</u> (yes or no) (organization running log) | | | |
| (8) how well bottom plugged <u>wood plug</u> | | | |
| DRILLERS REMARKS: | | | |

JAN 26 1973
JAN 26 1973

If well telescopes please sketch and show depths.

GROUND LEVEL

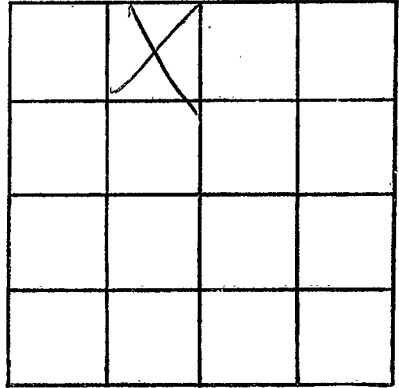

SECTION 2

Please indicate well location X.

ADDITIONAL INFORMATION

Horizontal lines for additional information.

If more than one screen; show locations of each on sketch.