

CODED

WILKINSON
T 22
10-26-72

MISSISSIPPI
BOARD OF WATER COMMISSIONERS
416 North State Street
Jackson, Mississippi 39201

WATER WELL DRILLERS LOG

Oct 26 1972 date well completed
Chester Keener Wilkinson firm name
Wilkinson county well located

LANDOWNER: Henry Darden
P.O. Centerville
(mailing address)

WELL LOCATION:
sec. 41 T 1 N R 1 E
6 miles SW Centerville
(distance) (direction) (nearest town)

WELL PURPOSE: Home Farm
(home, irrigation, municipal, industrial)

- WELL COMPLETION DATA:
- (1) diameter (inches) 14"
 - (2) total depth (feet) 125
 - (3) static water level (feet) 70 below top of ground.
 - (4) casing Plast. battens
(material) (depth)
 - _____ if telescope see back.
(size)
 - (5) screen 6' 119'
(length) (depth to top)
 - 1 1/2" Plast
(size) (material)
 - (6) pump 3/4 Sub 15
(HP) (yield gpm)
 - Elect.
(type power)
 - (7) electric log no
(yes or no)
 - _____ (organization running log)
 - (8) how well bottom plugged was dug plug.

description of formations encountered	from	to
Red clay	0	16
Red sand	16	68
Small gravel sand	68	93
Red chalk	93	107
Coarse sand	107	112
sand-gravel	112	119
Peagraned	119	125


CODED

MAR 19 1973

DRILLERS REMARKS:

If well telescopes please sketch and show depths.

GROUND LEVEL

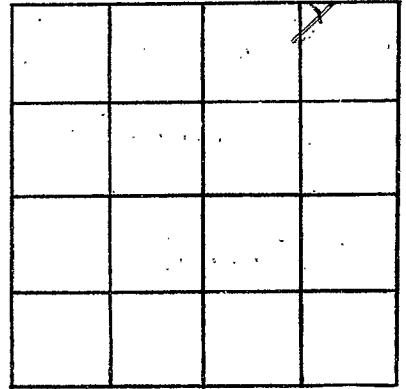

SECTION 41

Please indicate well location X.

ADDITIONAL INFORMATION

If more than one screen,
show locations of each on sketch.