

WILKINSON
T 23
11-16-72

MISSISSIPPI
BOARD OF WATER COMMISSIONERS
416 North State Street
Jackson, Mississippi 39201

CODED

WATER WELL DRILLERS LOG

Nov 16 1972 date well completed
Chester Reems well drillers firm name
Wilkinson county well located

LANDOWNER: Shirley D. Smith
Broadway Ranches, Inc.
Centerville, Miss.
(mailing address)

description of formations encountered	from	to
Red Clay	0	17
Red sand & gravel	17	34
white chalk	34	104
fine sand	104	127
lean gravel & sand	127	150

WELL LOCATION:
sec. 15 T. 1 N. R. 1 E
3 miles SW of Centerville
(distance) (direction) (nearest town)

WELL PURPOSE: Home
(home, irrigation, municipal, industrial)

WELL COMPLETION DATA:

- (1) diameter (inches) 4"
- (2) total depth (feet) 150
- (3) static water level (feet) 55 below top of ground.
- (4) casing Plast Ballam
(material) (depth)
- (5) screen 6" Ballam
(length) (depth to top)
- 4" Plast
(size) (material)
- (6) pump 1 1/2 HP 20
(HP) (yield gpm)
- Elect
(type power)
- (7) electric log yes
(yes or no)

(organization running log)

(8) how well bottom plugged
working

DRILLERS REMARKS:
all well
satisfactory


CODED

MAR 12 1973

If well telescopes please
sketch and show depths.

GROUND LEVEL

odd shaped
Section

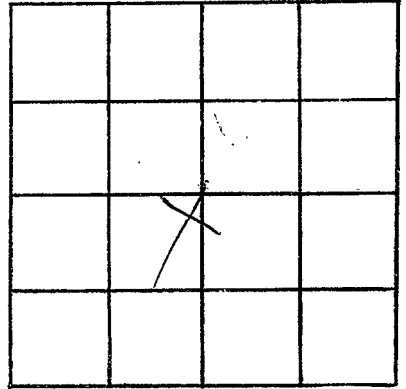

SECTION 15

Please indicate well location X.

ADDITIONAL INFORMATION

If more than one screen,
show locations of each on sketch.