

T 24
 WILKINSON
 4-20-73

MISSISSIPPI
 BOARD OF WATER COMMISSIONERS
 416 North State Street
 Jackson, Mississippi 39201

CODED

WATER WELL DRILLERS LOG

April 20 1973 Chester Keener Wilkinson
 date well completed firm name county well located

LANDOWNER: Robert Walker
 Centerville
 (mailing address)

WELL LOCATION:
 sec. 2 T. 1 N. R. 1 E.
 1/4 miles SSW Chickasaw
 (distance) (direction) (nearest town)

WELL PURPOSE: Farm
 (home, irrigation, municipal, industrial)

- WELL COMPLETION DATA:
- (1) diameter (inches) 4"
 - (2) total depth (feet) 92
 - (3) static water level (feet) 67 below top of ground.
 - (4) casing Plast Ballon
 (material) (depth)
 - _____ If telescope see back.
 (size)
 - (5) screen 6' 86'
 (length) (depth to top)
 - 4" Plast
 (size) (material)
 - (6) pump 1/2 Sub 15
 (HP) (yield gpm)
 - Elect
 (type power)
 - (7) electric log NO
 (yes or no)
 - _____ (organization running log)

description of formations encountered	from	to
Red clay	0	19
Red sand	19	60
Sand & gravel	60	68
chalky sand	68	85
Coarse sand & gravel	85	92


(8) how well bottom plugged
wooden plug

DRILLERS REMARKS:
New house

AUG 20 1973

If well telescopes please sketch and show depths.

GROUND LEVEL

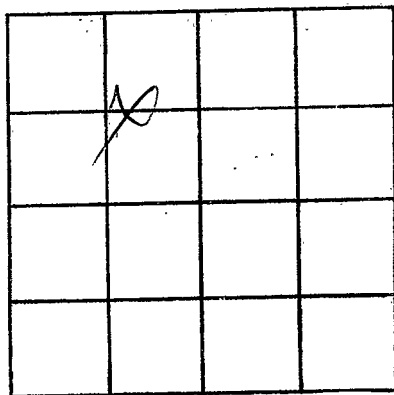

SECTION 2

Please indicate well location X.

ADDITIONAL INFORMATION

If more than one screen, show locations of each on sketch.