

MISSISSIPPI
BOARD OF WATER COMMISSIONERS
416 North State Street
Jackson, Mississippi 39201

COD

WATER WELL DRILLERS LOG

T 25
WILKINSON
4-26-73

April 26 1973 Chester Deener Wilkinson
date well completed firm name county well located

LANDOWNER: Hal Brannan
Woodville -

description of formations encountered	from	to
clay	0	19
Sand & gravel	19	72
white chalk	72	92
Sand & gravel	92	103
mixed Sand & chalk	103	160
fine sand	160	193
coarser sand	193	208

(mailing address)

WELL LOCATION:

sec 19 T 1 N R 1 E
7 miles SE of Woodville
(distance) (direction) (nearest town)

WELL PURPOSE: Home
(home, irrigation, municipal, industrial)

WELL COMPLETION DATA:

- (1) diameter (inches) 4"
- (2) total depth (feet) 208
- (3) static water level (feet) 117 below top of ground
- (4) casing Plast. balltam (material) (depth)
- (5) screen 6' (length) 202 (depth to top)
- (6) pump 3/4 sub 15 (HP) (yield gpm)
- (7) electric log no (yes or no)

If telescope see back.

(size)

(type power)

(organization running log)


(8) how well bottom plugged
wooden plug -

DRILLERS REMARKS:
New location

AUG 20 1973

If well telescopes please sketch and show depths.

GROUND LEVEL

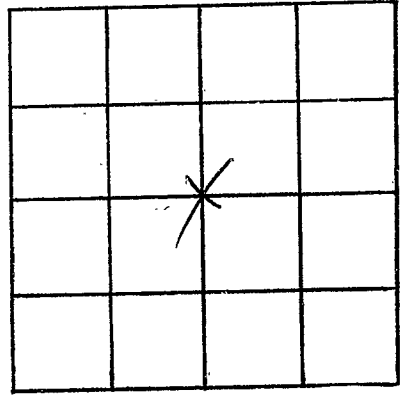

SECTION 19

Please indicate well location X.

ADDITIONAL INFORMATION

If more than one screen,
show locations of each on sketch.