

WILKINSON

T26

9-21-73

MISSISSIPPI BOARD OF WATER COMMISSIONERS **CODED**
 416 North State Street
 Jackson, Mississippi 39201

WATER WELL DRILLERS LOG

9-21 date well completed

1973 Flynn & Leland Inc firm name

Wilkinson county well located

LANDOWNER:	description of formations encountered	from	to
<u>Cliff Rogers</u> <u>R.R. Centerville Miss.</u> (mailing address)	<u>Red clay</u> <u>Blue clay</u> <u>Green sand</u>	<u>0</u> <u>20</u> <u>130</u>	<u>20</u> <u>130</u> <u>144</u>
WELL LOCATION: sec. <u>2</u> T. <u>1</u> N. R. <u>1</u> E. <u>IN S</u> <u>IE W</u> <u>3</u> miles <u>SW</u> of <u>Centerville</u> (distance) (direction) (nearest town)			
WELL PURPOSE: <u>Home</u> (home, irrigation, municipal, industrial)			
WELL COMPLETION DATA:			
(1) diameter (inches) <u>4</u>			
(2) total depth (feet) <u>144</u>			
(3) static water level (feet) <u>100</u> below above top of ground.			
(4) casing <u>plastic</u> , <u>136</u> , (material) (depth) <u>4</u> if telescope see back. (size)			
(5) screen <u>8</u> , <u>136</u> (length) (depth to top) <u>4</u> , <u>plastic</u> (size) (material)			
(6) pump <u>1/2</u> , <u>10</u> (HP) (yield gpm) <u>elec</u> (type power)			
(7) electric log <u>yes</u> (yes or no)			
(organization running log)			
(8) how well bottom plugged <u>full</u>			
DRILLERS REMARKS:			


CODED

OCT 9 1973

MISS. Bd. OF WATER COMMISSIONERS

If well telescopes please
sketch and show depths.

GROUND LEVEL

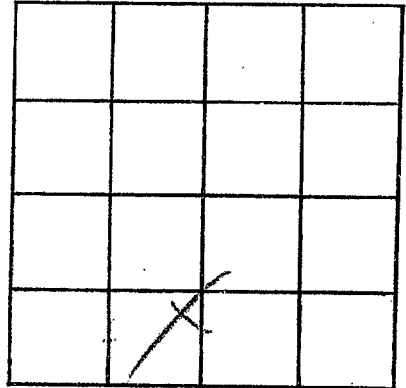

SECTION 7

Please indicate well location X.

ADDITIONAL INFORMATION

If more than one screen,
show locations of each on sketch.