

WILKINSON

T36

2-22-79

Feb-22 1979

date well completed

BOARD OF WATER COMMISSIONERS

416 North State Street

Jackson, Mississippi 39201

CODED

WATER WELL DRILLERS LOG

1979 Reynolds Miller Wilkinson

firm name

county well located

LANDOWNER:

George Davis

Centerville

(mailing address)

WELL LOCATION:

sec. 12 T-1 N R-1 E  
2 miles West of Centerville  
(distance) (direction) (nearest town)

WELL PURPOSE: fish pond  
(home, irrigation, municipal, industrial)

WELL COMPLETION DATA:

- (1) diameter (inches) 4"
- (2) total depth (feet) 160
- (3) static water level (feet) 95 below/above top of ground.
- (4) casing plastic bottom  
(material) (depth)
- 7 if telescope see back.  
(size)
- (5) screen 20' 140'  
(length) (depth to top)
- 4" plastic  
(size) (material)
- (6) pump 3 sub 45'  
(HP) (yield gpm)
- 1150  
(type power)
- (7) electric log no  
(yes or no)

(organization running log)

(8) how well bottom plugged  
wooden plug

DRILLERS REMARKS:

description of formations encountered

from

to

<u>clay</u>	<u>0</u>	<u>24</u>
<u>sand + gravel</u>	<u>24</u>	<u>50</u>
<u>clay</u>	<u>50</u>	<u>83</u>
<u>sand + gravel</u>	<u>83</u>	<u>110</u>
<u>fine cherty sand</u>	<u>110</u>	<u>140</u>
<u>coarse sand</u>	<u>140</u>	<u>160</u>

CODED


Miss. Board of Water Comm.

JUN 18 1979

RECEIVED

If well telescopes please sketch and show depths.

GROUND LEVEL

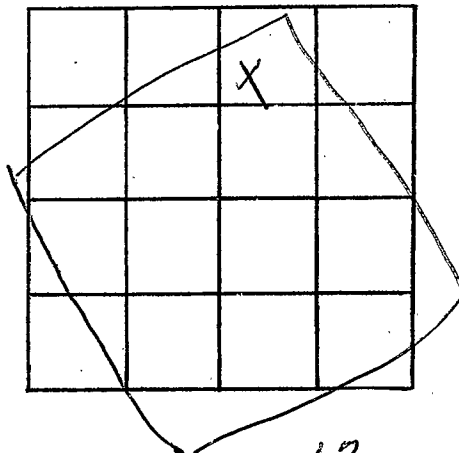

SECTION 12

Please indicate well location X.

ADDITIONAL INFORMATION

If more than one screen,  
show locations of each on sketch.