

WILKINSON

MISSISSIPPI DEPARTMENT OF NATURAL RESOURCES
Bureau of Land and Water Resources

Southport Mall
P.O. Box 10631

Jackson, Mississippi 39209
WATER WELL DRILLERS LOG CODED

T 37

2-21-80

Feb 21 1980

date well completed

1980 *Beaver Millers* *Wilkinson*

firm name

county well located

LANDOWNER:

description of formations encountered

from

to

Georgia Pacific Co.
Centerville
(mailing address)

Clay 0 17
Red dirt 19 90
small gravel 90 115
gravel 115 166
white chert 166 175
fine sand 175 195
coarse sand 175 203
+ peagrand

WELL LOCATION:

sec. *24* T *1* N R *1* E
2 1/2 miles *W.S.W.* of *Centerville*
(distance) (direction) (nearest town)

WELL PURPOSE: *Industrial*
(home, irrigation, municipal, industrial)

WELL COMPLETION DATA:

- (1) diameter (inches) *4"*
- (2) total depth (feet) *203*
- (3) static water level (feet) *120* 'below top of ground.
- (4) casing *plastic* bottom
(material) (depth)
- (5) screen *30'* *173'*
(length) (depth to top)
- (6) pump *4"* *plastic*
(size) (material)
- (7) pump *5 sub* *90'*
(HP) (yield gpm)
- (8) electric log *elect*
(type power)
- (9) electric log *no*
(yes or no)

(organization running log)

(8) how well bottom plugged *Wooden plug*

DRILLERS REMARKS:


DEPT. OF NATURAL RESOURCES
BUREAU OF LAND & WATER RESOURCES

DEC - 1 1980

RECEIVED

If well telescopes please sketch and show depths.

GROUND LEVEL

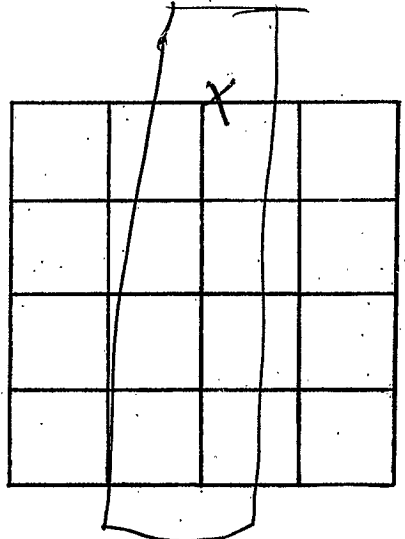

SECTION 24

Please indicate well location X.

ADDITIONAL INFORMATION

If more than one screen,
show locations of each on sketch.