

MISSISSIPPI DEPARTMENT OF NATURAL RESOURCES

Bureau of Land and Water Resources

Southport Mall

P.O. Box 10631

Jackson, Mississippi 39209

WATER WELL DRILLERS LOG

Wilkinson
T39
3-2-82

325

3-2 1982 Newsum Wilkinson
 date well completed firm name county well located

LANDOWNER:
J. W. Reese
Canterville
 (mailing address)

description of formations encountered	from	to
<u>Clay</u>	<u>0</u>	<u>25</u>
<u>Sand & gravel</u>	<u>25</u>	<u>65</u>
<u>Red Chalk</u>	<u>65</u>	<u>75</u>
<u>White Chalk</u>	<u>75</u>	<u>110</u>
<u>Thin Chalky sand</u>	<u>110</u>	<u>160</u>
<u>Sand & red gravel</u>	<u>160</u>	<u>169</u>

WELL LOCATION:
 sec 26 T 1 N R 1 E
3 miles South of Canterville
 (distance) (direction) (nearest town)

WELL PURPOSE: home
 (home, irrigation, municipal, industrial)

WELL COMPLETION DATA:

(1) diameter (inches) 4"

(2) total depth (feet) 169

(3) static water level (feet) 85 below top of ground.

(4) casing plastic bottom
 (material) (depth)

_____ if telescope see back.
 (size)

(5) screen 5' 164'
 (length) (depth to top)

4" plastic
 (size) (material)

(6) pump gyathus
 (HP) (yield gpm)

elect
 (type power)

(7) electric log no
 (yes or no)

_____ (organization running log)

(8) how well bottom plugged best mud

Elevation: 280 feet

0910355 310156

DRILLERS REMARKS:
Safe well vent
and


DEPT. OF NATURAL RESOURCES
 BUREAU OF LAND & WATER RESOURCES

JUL 15 1982

RECEIVED

If well telescopes please
sketch and show depths.

GROUND LEVEL

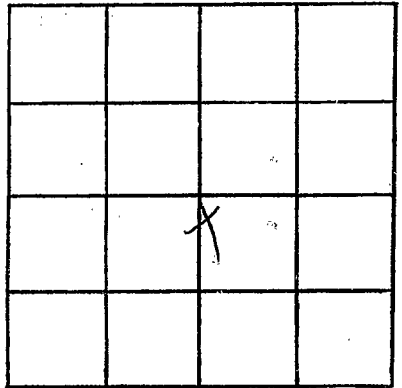

SECTION 36

Please indicate well location X.

ADDITIONAL INFORMATION

If more than one screen,
show locations of each on sketch.