

MISSISSIPPI DEPARTMENT OF NATURAL RESOURCES

Bureau of Land and Water Resources

Southport Mall

P.O. Box 10631

Jackson, Mississippi 39209

WATER WELL DRILLERS LOG

CODED

WILKINSON
T 39

4-18-85

Griner Drilling Service Inc.

Wilkinson

date well completed

firm name

county well located

LANDOWNER:

See Land Drilling
900 Dunn Street
Houma, La. 70360
(mailing address)

description of formations encountered

from

to

sand, gravel

0 156

clay

156 252

sand, p. gravel

252 273

clay

273 315

sand

315 407

clay

407 420

WELL LOCATION: 1433'N+ 982'W

sec. 13 T. 1 N R. 1 E of

Amerada Hess Corp. Centreville
No. (distance) miles (direction) of (nearest town)

WELL PURPOSE: oilfield supply
Plantation (agriculture, municipal, industrial)

WELL COMPLETION DATA:

(1) diameter (inches) 3"

(2) total depth (feet) 420'

(3) static water level (feet) 80' below top of ground.

(4) casing steel 399' (material) (depth)

3" (size) if telescope see back.

(5) screen 420' 357' (length) (depth to top)

3" (size) perforated (material)

(6) pump 75 (HP) (yield gpm)

AC (type power)

(7) electric log (yes or no)

(organization running log)

(8) how well bottom plugged orange peel

DRILLERS REMARKS:

CODED


RECEIVED

APR 30 1985

Department of Natural Resources
Bureau of Land & Water Resources

If well telescopes please
sketch and show depths.

GROUND LEVEL

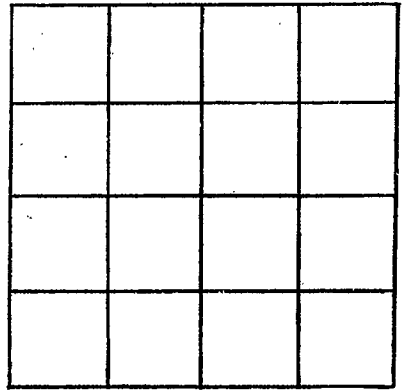

SECTION _____

Please indicate well location X.

ADDITIONAL INFORMATION

If more than one screen,
show locations of each on sketch.