

MISSISSIPPI DEPARTMENT OF NATURAL RESOURCES
 Bureau of Land and Water Resources
 Southport Mall
 P.O. Box 10631
 Jackson, Mississippi 39209
WATER WELL DRILLERS LOG

WILKINSON
T 40
CODED

8-15-88
 date well completed

Morphis Bros Inc.
 firm name

Wilkinson
 county well located


LANDOWNER: Mid South Drilling
1824 Capital Tower
Jackson, Miss. 39201
 (mailing address)

description of formations encountered	from	to
white clay	0	20
white clay	20	60
white clay Gravel	60	80
Sandy clay	80	100
Fine sandy clay	100	120
med. coarse sand	120	167
Salt & Pepper		

WELL LOCATION:
 sec. 44 T. 1 (N) R. 1 (E)
6 miles S of Centerville
 (distance) (direction) (nearest town)

WELL PURPOSE: Rig Supply
 (home, irrigation, municipal, industrial)

- WELL COMPLETION DATA:
- (1) diameter (inches) 7 7/8"
 - (2) total depth (feet) 167
 - (3) static water level (feet) 62 ^(below) above top of ground.
 - (4) casing 4" PVC, 147
 (material) (depth)
 (size) if telescope see back.
 - (5) screen 20, 147
 (length) (depth to top)
4", PVC sch 40
 (size) (material)
 - (6) pump 5, 75
 (HP) (yield gpm)
Electric
 (type power)
 - (7) electric log no
 (yes or no)
 (organization running log)
 - (8) how well bottom plugged Back
wash valve

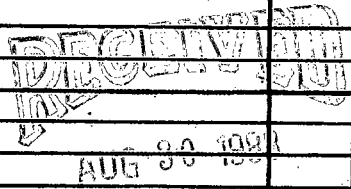

Department of Natural Resources
 Bureau of Land and Water Resources

DRILLERS REMARKS:

If well telescopes please sketch and show depths.

GROUND LEVEL

	X		

SECTION 44

Please indicate well location X.

ADDITIONAL INFORMATION

147

167

BW

If more than one screen, show locations of each on sketch.