

T-56
WILKINSON
8-26-80

MISSISSIPPI
 BOARD OF WATER COMMISSIONERS **CODED**
 416 North State Street
 Jackson, Mississippi 39201
 WATER WELL DRILLERS LOG

8-26 1980 Fitzgerald Well Drilling Wilkinson
 date well completed firm name county well located

LANDOWNER:
Cliff Rogers
P.O. Contreras
 (mailing address)

WELL LOCATION:
 sec. 6 T 1 N R 1 E
 S W
3 miles SW of Centerville
 (distance) (direction) (nearest town)

WELL PURPOSE: Abstraction
 (home, irrigation, municipal, industrial)

WELL COMPLETION DATA:
 (1) diameter (inches) 4
 (2) total depth (feet) 172
 (3) static water level (feet) 105 below
 top of ground.
 (4) casing PUC, 156
 (material) (depth)
 4 if telescope see back.
 (size)
 (5) screen 16, 156
 (length) (depth to top)
 4, PUC
 (size) (material)
 (6) pump 3 50
 (HP) (yield gpm)
 elec
 (type power)
 (7) electric log no
 (yes or no)
 (organization running log)
 (8) how well bottom plugged Seal Shk


| description of formations encountered | from | to |
|---------------------------------------|------------|------------|
| <u>Red clay</u> | <u>0</u> | <u>22</u> |
| <u>Red sand</u> | <u>22</u> | <u>92</u> |
| <u>White & Blue Clay</u> | <u>92</u> | <u>155</u> |
| <u>Coarse sand & gravel</u> | <u>155</u> | <u>172</u> |
| CODED | | |

DRILLERS REMARKS:

DEPT. OF NATURAL RESOURCES
 BUREAU OF LAND & WATER RESOURCES
 SEP 8 - 1980
RECEIVED

If well telescopes please sketch and show depths.

GROUND LEVEL

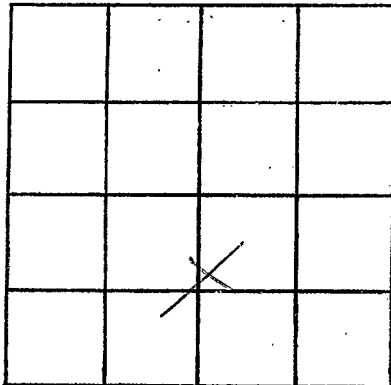

SECTION 6

Please indicate well location X.

ADDITIONAL INFORMATION

If more than one screen, show locations of each on sketch.