

Wilkinson

T 57

6-18-85

MISSISSIPPI
BOARD OF WATER COMMISSIONERS
416 North State Street
Jackson, Mississippi 39201

CODED

WATER WELL DRILLERS LOG

Griner Drilling
Service, INC.

Wilkinson

6-18-85, date well completed

Griner Drilling Service, INC. firm name

Wilkinson county well located

LANDOWNER:

See Land Drilling
900 Dunn St.
Houma, La. 70160
(mailing address)

description of formations encountered

from to

clay	0	25
sand	25	55
streaked	55	90
sand, ped gravel	90	190
streaked sand	190	400
sand	400	444

WELL LOCATION:

2919' N + 2044' W

sec. 40 T 1 N R 1 E of S 1000
Amerada Hess Corp. Centreville
No. 1 Foster (direction) (nearest town)

WELL PURPOSE: oilfield supply
(home, irrigation, municipal, industrial)

WELL COMPLETION DATA:

- (1) diameter (inches) 3"
- (2) total depth (feet) 444'
- (3) static water level (feet) 80' below top of ground.
- (4) casing steel 444' (material) (depth)
3" (size) If telescope see back.
- (5) screen 42' 399' (length) (depth to top)
3" perforated (size) (material)
- (6) pump 80 (HP) (yield gpm)
AC (type power)
- (7) electric log (yes or no) (organization running log)
- (8) how well bottom plugged orange
peel


RECEIVED

JUL 1 1985

DRILLERS REMARKS:

If well telescopes please sketch and show depths.

GROUND LEVEL

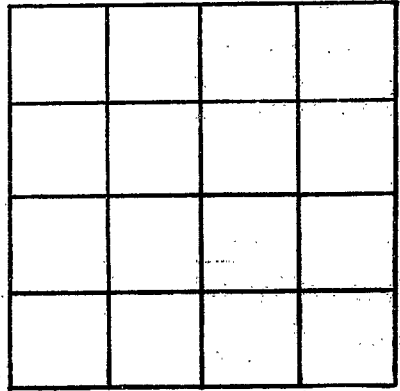

SECTION _____

Please indicate well location X.

ADDITIONAL INFORMATION

If more than one screen, show locations of each on sketch.