

Part 2 never received 4/13

State Well Report

Part 1

Mississippi Department of Environmental Quality
Office of Land and Water Resources
P.O. Box 10631
Jackson, MS 39289-0631
(601)961-5210
(601)354-6938 (fax)

For Office Use Only:

Aquifer: _____
Well #: T-110
L. S. Elevation: _____
E-log #: _____

County: Wilkinson
Permit #: _____
Driller: Ingre Seascione, Inc.
Date drilling completed: 2-15-05

State Law requires that this report be prepared by the driller in detail and filed with the Department within 30 days of completion of drilling of the well.

| Well Owner Information | Well Location |
|---|---|
| Owner Name <u>Exxon Mobil Corporation</u> | Latitude: <u>N31.04.11.8</u> , Longitude: <u>W91.07.24.2</u> |
| Mailing Address: <u>P.O. Box 551</u> | Method of Lat/Long (circle one): <u>Conventional Survey</u> |
| <u>Baton Rouge, LA 70821-0551</u> | USGS quad, <u>Hand-held GPS</u> , Survey-grade GPS |
| City State Zip Code | <u>1R</u> <u>1R</u> <u>1/4</u> Sec <u>12</u> <u>1</u> Twn <u>1N</u> Rng <u>1E</u> |
| Telephone No. <u>(225) 977-7466</u> | Distance Direction Nearest Town <u>1.5</u> Miles <u>West</u> of <u>Centreville</u> |

Well Data

Purpose of Well (circle one) Home Industrial Public Supply Irrigation Fish Culture Other: _____

Date well drilling started: 02-09-05 Date well drilling completed: 02-15-05

If flowing, method of flow regulation: Valve _____ Other (describe) _____

Static Water Level: 42 feet above or below (circle one) land surface Date measured: 02-12-05

Method of Measurement (circle one) steel tape electric tape air line other: _____

Hole depth: 63 Ft. Well depth: 62 Ft. Well grouted to a depth of 44 feet

Type of grout (circle one): Cement Bentonite Mix

Casing length: 52 feet Casing diameter: 4 inches Type of casing: Sch 40 PVC

Screen length: 10 feet Screen diameter: 4 inches Type of screen: Sch 40 PVC

Screen slot size: 0.006 inches Setting depth: From 50 feet to 60 feet

Type of completion (circle all applicable): Gravel packed Underreamed Telescoped Open hole Natural Development

Other (describe): Pre-pack Silica Sand

Top of lap pipe or reduction in casing: _____ feet. If telescoped or more than one screen, describe on back of page


Logs run (circle all applicable): No log run Electric Gamma Ray Density Sonic Neutron Other: _____

Name of organization running log(s): _____

I certify that the well was drilled, constructed, and completed in accordance with all applicable requirements of the Mississippi Department of Environmental Quality and/or the Mississippi Department of Health regulations and state laws.

Beaumont J. Rogers 0-557 _____
Print Name of Water Well Contractor and License No. Signature of Water Well Contractor

RECEIVED
MAY 09 2005
BY: OLWR

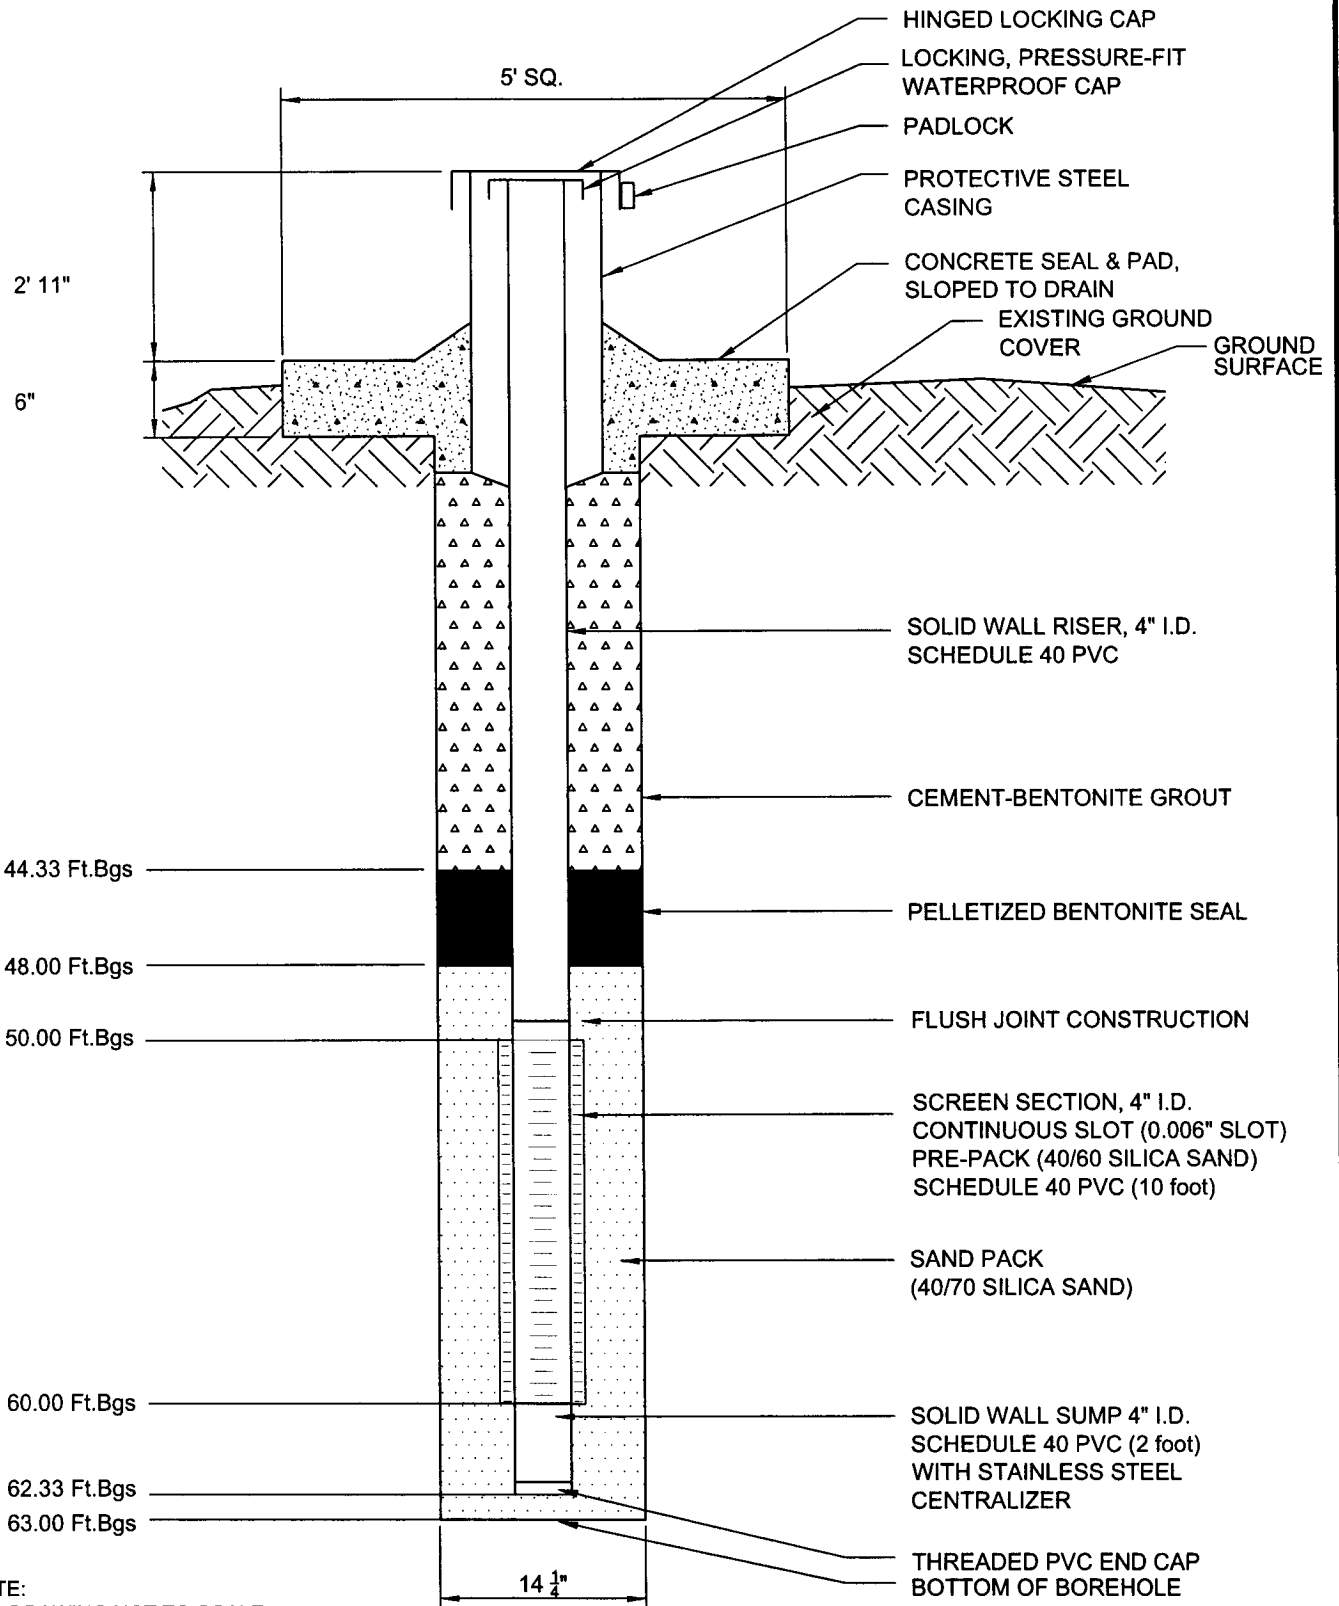

NOTE:
 1. DRAWING NOT TO SCALE
 2. Ft.Bgs = FEET BELOW GROUND SURFACE

ERM-Southwest, Inc.
 HOUSTON · NEW ORLEANS · AUSTIN · MOBILE · BEAUMONT · BATON ROUGE

M-3A
 WELL CONSTRUCTION DETAILS
 COMPLETED ABOVE GRADE
 FEBRUARY 12, 2005
 Centreville Landfarm Facility
 Exxon Mobil Corporation
 Centreville, Mississippi

| | | |
|--------------------------|-----------------|----------------|
| DESIGN: DBH | DRAWN: MHB | CHKD.: DBH |
| DATE: 03/02/05 | SCALE: AS SHOWN | REV.: 04/21/05 |
| W.O.NO.: 0025178L301 C05 | | |

RECEIVED



MAY 09 2005

BY: OLWR