

State Well Report

Part 1

Mississippi Department of Environmental Quality
Office of Land and Water Resources
P.O. Box 10631
Jackson, MS 39289-0631
(601)961-5210
(601)354-6938 (fax)

For Office Use Only:

Aquifer: _____
Well #: T-112
L. S. Elevation: _____
E-log #: _____

County: Wilkinson
Permit #: _____
Driller: _____
Date drilling completed: 2/15/05

State Law requires that this report be prepared by the driller in detail and filed with the Department within 30 days of completion of drilling of the well.

Well Owner Information	Well Location
Owner Name <u>Exxon Mobil Corporation</u>	Latitude: <u>N31.0411.8</u> , Longitude: <u>W91.0724.2</u>
Mailing Address: <u>P.O. Box 551</u>	Method of Lat/Long (circle one): <u>Conventional Survey</u>
<u>Baton Rouge, LA 70821-0551</u>	USGS quad, <u>Hand-held GPS</u> , Survey-grade GPS
City State Zip Code	<u>1/4 1/4 Sec 12 Twn 1N Rng 1E</u>
Telephone No. () _____	Distance Direction Nearest Town <u>1.5 Miles West of Centreville</u>

Well Data

Purpose of Well (circle one) Home Industrial Public Supply Irrigation Fish Culture Other: _____

Date well drilling started: 02-09-05 Date well drilling completed: 02-15-05

If flowing, method of flow regulation: Valve _____ Other (describe) _____

Static Water Level: 42 feet above or below (circle one) land surface Date measured: 02-12-05

Method of Measurement (circle one) steel tape electric tape air line other: _____

Hole depth: 65 Ft. Well depth: 65 Ft. Well grouted to a depth of 47 feet

Type of grout (circle one): Cement Bentonite Mix

Casing length: 55 feet Casing diameter: 4 inches Type of casing: Sch 40 PVC

Screen length: 10 feet Screen diameter: 4 inches Type of screen: Sch 40 PVC

Screen slot size: 0.006 inches Setting depth: From 53 feet to 63 feet

Type of completion (circle all applicable): Gravel packed Underreamed Telescoped Open hole Natural Development
Other (describe): Pre-pack Silica Sand

Top of lap pipe or reduction in casing: _____ feet. If telescoped or more than one screen, describe on back of page

Logs run (circle all applicable): No log run Electric Gamma Ray Density Sonic Neutron Other: _____

Name of organization running log(s): _____


I certify that the well was drilled, constructed, and completed in accordance with all applicable requirements of the Mississippi Department of Environmental Quality and/or the Mississippi Department of Health regulations and state laws.

Beaumont J. Rogers 0-557 _____
Print Name of Water Well Contractor and License No. Signature of Water Well Contractor

RECEIVED

APR 20 2005

BY: OLWR

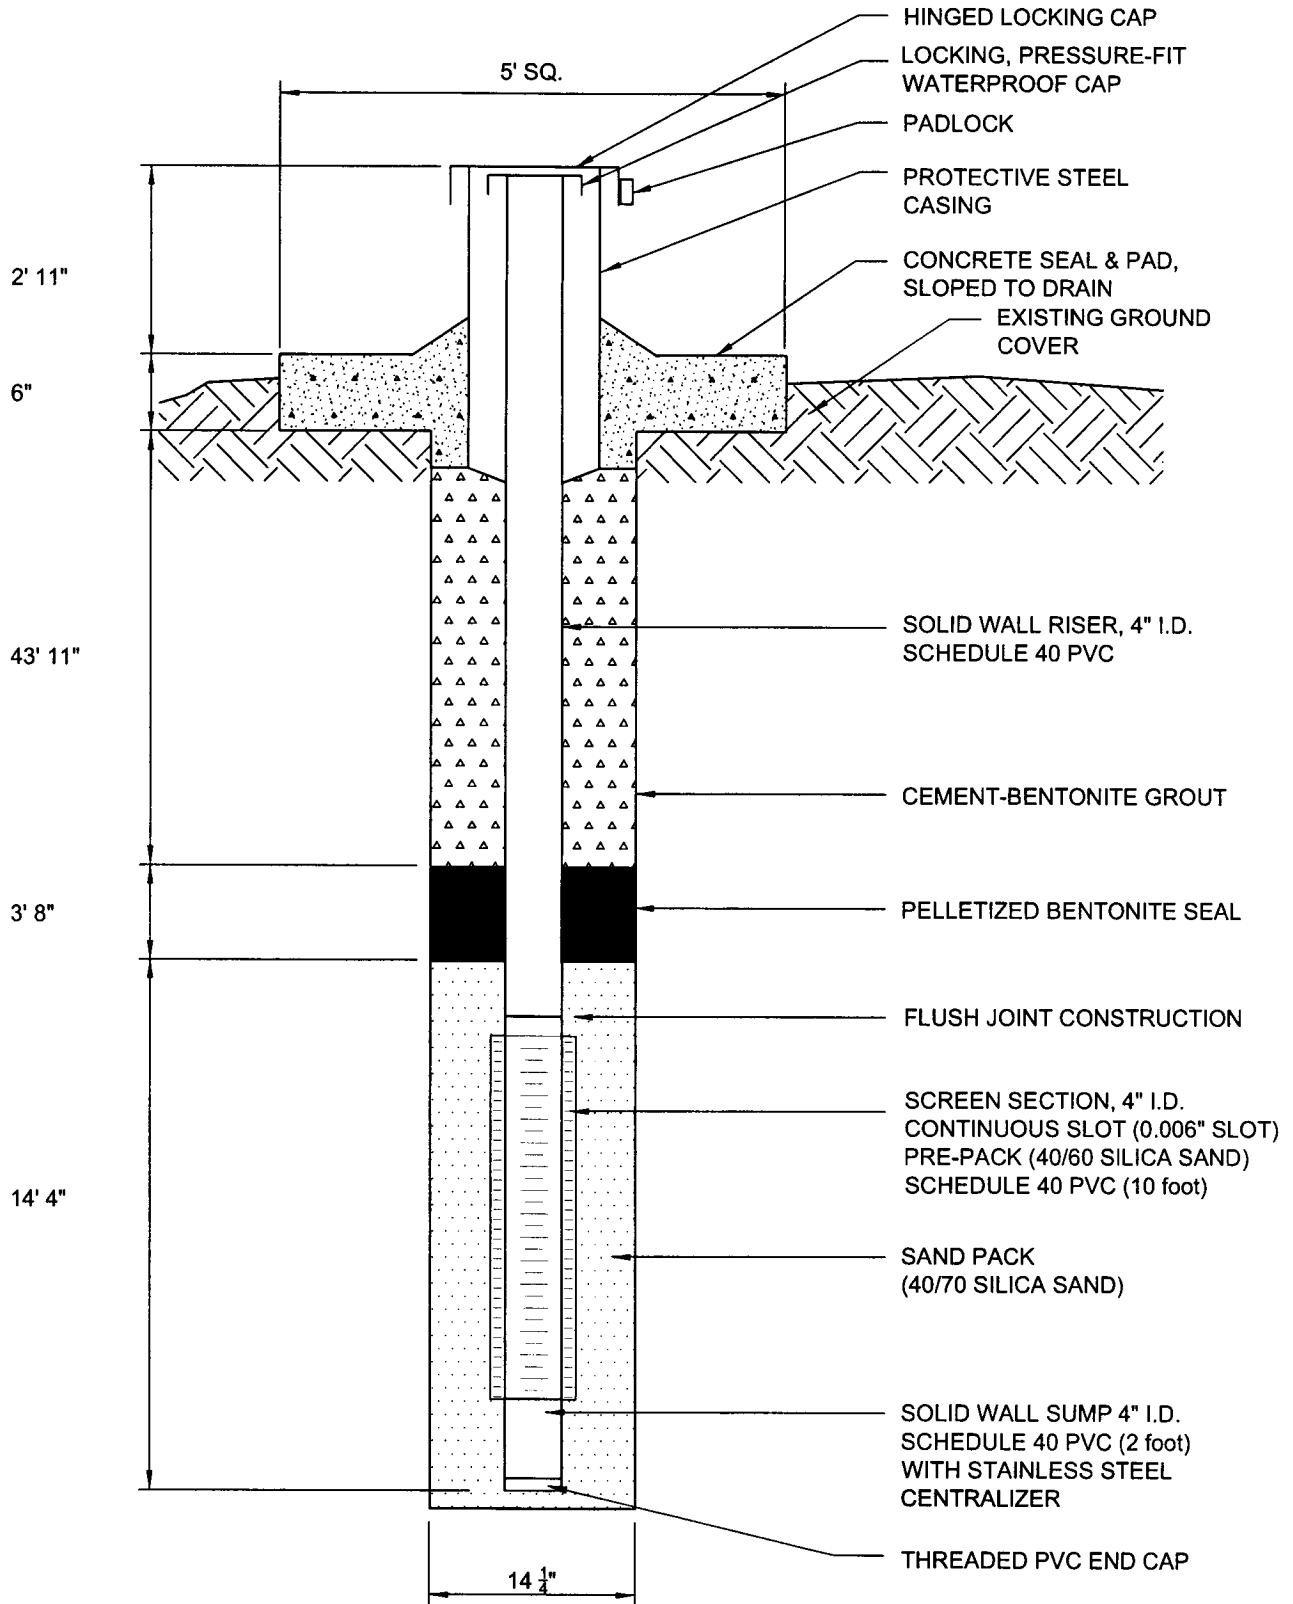

NOTE: DRAWING NOT TO SCALE

ERM-Southwest, Inc.
 HOUSTON · NEW ORLEANS · AUSTIN · MOBILE · BEAUMONT · BATON ROUGE

DESIGN: DBH	DRAWN: MHB	CHKD.: DBH
DATE: 03/02/05	SCALE: AS SHOWN	REV.:
W.O.NO.: 0025178L301 C05		

M-3A
 WELL CONSTRUCTION DEPLETED ABOVE GRADE
 FEBRUARY 12, 2005
 Centreville Landfarm Facility
 Exxon Mobil Corporation
 Centreville, Mississippi

RECEIVED
 APR 20 2005
 BY OLWR

