1	State Well Report	For Office Use Only:	
County: Wilkinson	Part 1		
Permit #:	sissippi Department of Environmental Qual Office of Land and Water Resources	Well #:	
Driller: Gary Rayborn	P.O. Box 10631	1 .	
Date drilling completed:730 09	Jackson, MS 39289-0631 (601)961-5210	L. S. Elevation:	
	(601)354-6938 (fax)	E-log #:	
State Law requires that this report b 30 days of completion of drilling of t	e prepared by the driller in detail and file he well.	ed with the Department within	
Well Owner Information		Well Location	
Owner Name_Darry Hall	Latitude: <u>31 • 0 0 '</u> .	<u>23</u> " Longitude: <u>21 • 63 • 36</u> "	
Mailing Address: 7054 W.T	Hall Rd Method of Lat/Long (circ	cle one): Conventional Survey,	
		-held GPS, Survey-grade GPS	
Ethel LA City State	<u>70730</u> <u>SE 14 NE 14 Sec</u> Zip Code	49 Twn N Rng IE	
Selephone No. ( <u>225, 937-9738</u>		of <u>Centreville</u>	
	Well Data		
Purpose of Well (circle one) Home Industri	al Public Supply Irrigation Fish Cultu	re Other:	
	Date well drilling completed:		
	· · · · · · · · · · · · · · · · · · ·		
f flowing, method of flow regulation: Valve	Other (describe)	(1.2) ()	
Static Water Level:feet above	or below (circle one) land surface Date measure	ured: <u>1-30-09</u>	
Method of Measurement (circle one) steel ta			
Hole depth; 2001 Well depth:	ZOO' Well grouted to a depti	h of <u> </u>	
	entonite Mix		
		ng: PVC	
<i>v v v v</i>	iameter: inches Type of casi	ng:	
		en: $PVC$	
Screen slot size: <u>010</u> inches	Setting depth: From <u>180</u> feet to _	<u>200</u> feet	
Type of completion (circle all applicable): G	ravel packed Underreamed Telescoped	Open hole Natural Development	
C	Other (describe):		
Top of lap pipe or reduction in casing:	feet. If telescoped or more than or	ne screen, describe on back of page	
Logs run (circle all applicable). No log run I	Electric Gamma Ray Density Sonic Neutr	ron Other:	
Name of organization running log(s):	14	able nominements of the Mississinni	
	ed, and completed in accordance with all applic or the Mississippi Department of Health regula		
Department of Environmental Quanty and/o	n an mississippi reparament of meanin regul		
	0-60	ture of Water Well Confident CFI	

.

•


TUS

If well telescopes please sketch below and show depths.

Ground Level

	Description of Formations Encountered	From	To
	OHALK	0	10
	GRAVEL	10	80
	WHITE CHALK	80	155
	MEDIUM SAND	155	200
i.			
			<u> </u>
			<u> </u>
			<u> </u>

If more than one screen, show location of each on sketch

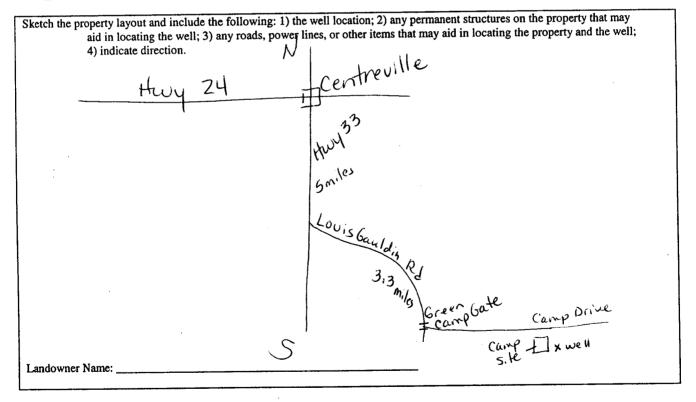

Signature of Water Well Contra

AUG 2 5 2009 BY: OLWR

المرو ال				
County: Wilkinson Permit #: Driller: Gary Rayborn Date completed:	STATE WELL REPORT Part 2 Pump Installer's Completion Report Mississippi Department of Environmental Quality Office of Land and Water Resources P.O. Box 10631 Jackson, MS 39289-0631 (601)961-5210 (601)354-6938 (fax)		For Office Use Only: Aquifer: Well #:	
This report should be prepared by the installation of pump.				
Well Owner Information Owner Name: Darry Hal		Well Location           Latitude:         31.00.33           Longitude:         31.00.33		
Mailing Address: <u>7054</u> , W.T. HallRJ <u>Ethel LA 70730</u> City State Zip Code		Method of Lat/Long (circle one): Conventional Survey, USGS quad, Hand-held GPS, Survey-grade GPS <u>SE 14 NE 14 Sec 49 Twn IN Rng IE</u> Distance Direction Nearest Town		
Telephone No. (225) 930 - 9732	<u>}</u>	<u> </u>	of <u>Centreville</u>	
Pump Type Circle one			Power Type Circle one	
Air Lift Jet Bucket Piston	Submersible -	Diesel Engine Gase Electric Motor Har	oline Engine Natural Gas	
Centrifugal   Rotary     Other (specify):				
Pump Test Data Date Well Tested: 7-30-0 Static Water Level (A): 70 Feet Pumping Water Level (B): Feet	( Below Land Surface	Air Line Electric M	Measuring Water Level Circle one Measuring Line Steel Tape	
Drawdown [(B) – (A)]:Feet Test Pumping Rate: Duration of Pump Test (minimum 4 hours)	_Gallons Per Minute	Well yielded	I shut in head:feet GPM with a drawdown of rhours of pumping	
I HEREBY CERTIFY that the above stater <u>Cary</u> Rayborn Print Name of Pump Installer and License	0-60	of my knowledge. Signature of Pum		

AUG 2 5 2009

BY: OLWR