

WILKINSON

T 2000

3-22-78

MISSISSIPPI BOARD OF WATER COMMISSIONERS 416 North State Street Jackson, Mississippi 39201

WATER WELL DRILLERS LOG

March 22 1978 Reeves Well Ser Wilkerson date well completed firm name county well located

LANDOWNER:

Joe Brian Rt Centerville (mailing address)

description of formations encountered

from to

Clay 0 12 sand & gravel 12 62 White Chalk 62 70 sand & gravel 70 82

WELL LOCATION:

sec 24 T 1 N R 1 E

2 1/2 miles South of Centerville (distance) (direction) (nearest town)

WELL PURPOSE: house (home, irrigation, municipal, industrial)


WELL COMPLETION DATA:

- (1) diameter (inches) 4" (2) total depth (feet) 80 (3) static water level (feet) 50' below top of ground. (4) casing plaster bottom (material) (depth) (5) screen 5' 25' (length) (depth to top) 4" plaster (size) (material) (6) pump 1/2 HP 150 (yield gpm) (type power) (7) electric log No (yes or no)

(organization running log)

(8) how well bottom plugged

DRILLERS REMARKS:

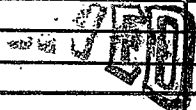


JUN - 8 1978

MISS. BO. OF WATER COMMISSIONERS

If well telescopes please sketch and show depths.

GROUND LEVEL

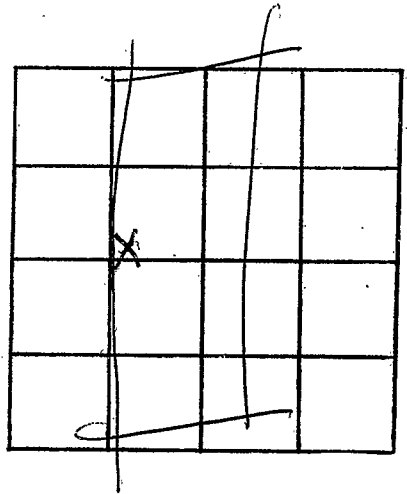

SECTION 214

Please indicate well location X.

ADDITIONAL INFORMATION

If more than one screen,  
show locations of each on sketch.