


WILKINSON
T
2001
3-23-78

MISSISSIPPI  
BOARD OF WATER COMMISSIONERS  
416 North State Street  
Jackson, Mississippi 39201

WATER WELL DRILLERS LOG

March 23 1978 Reems Well Co. Wilkinson  
date well completed firm name county well located


LANDOWNER:	description of formations encountered	from	to
Joe Briss At Centerville (mailing address)			
<b>WELL LOCATION:</b>			
sec. 34 T. 1 N. R. 1 E 3 miles South of Centerville (distance) (direction) (nearest town)			
<b>WELL PURPOSE:</b> Home (home, irrigation, municipal, industrial)			
<b>WELL COMPLETION DATA:</b>			
(1) diameter (inches) 4"			
(2) total depth (feet) 70			
(3) static water level (feet) 45 below top of ground.			
(4) casing plastic bottom (material) (depth) if telescope see back. (size)			
(5) screen 5' bottom (length) (depth to top) 4" plastic (size) (material)			
(6) pump by other (HP) (yield gpm) elect (type power)			
(7) electric log no (yes or no)			
(organization running log)			
(8) how well bottom plugged Wooden plug			
<b>DRILLERS REMARKS:</b>			

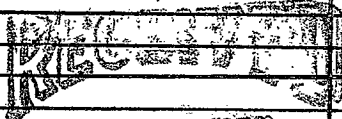

MAR - 8 1978

If well telescopes please sketch and show depths.

GROUND LEVEL

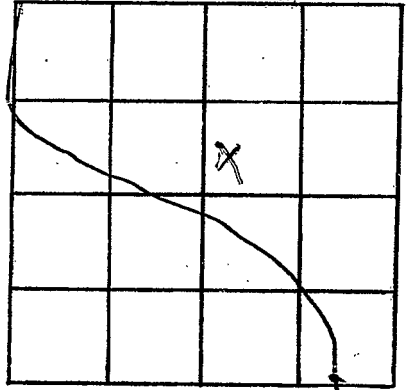

SECTION 34

Please indicate well location X.

ADDITIONAL INFORMATION

If more than one screen, show locations of each on sketch.