

WILKINSON

T 2002

4-1-78

MISSISSIPPI BOARD OF WATER COMMISSIONERS
416 North State Street
Jackson, Mississippi 39201

WATER WELL DRILLERS LOG

April 1, 1978 *Recess well for Wilkinson*
date well completed firm name county well located

LANDOWNER:

Joe Brion
At Centerville
(mailing address)

description of formations encountered

from to

clay 0 20
sand 20 50
white chalk 5 128
coarse sand 778 150

WELL LOCATION:

sec. 24 T 1 N R 1 E
2 miles South of Centerville
(distance) (direction) (nearest town)

WELL PURPOSE: Home
(home, irrigation, municipal, industrial)

WELL COMPLETION DATA:

- (1) diameter (inches) 4"
- (2) total depth (feet) 130
- (3) static water level (feet) 40 below top of ground
- (4) casing plastic, cotton
(material) (depth)
- if telescope see back.
(size)
- (5) screen 10' 140'
(length) (depth to top)
- 4" plastic
(size) (material)
- (6) pump in place
(HP) (yield gpm)
- elect
(type power)
- (7) electric log no
(yes or no)

(organization running log)

(8) how well bottom plugged
wooden plug

DRILLERS REMARKS:

[Signature]


RECEIVED

JUN - 8 1978

MISS. BD. OF WATER COMM

If well telescopes please sketch and show depths.

GROUND LEVEL

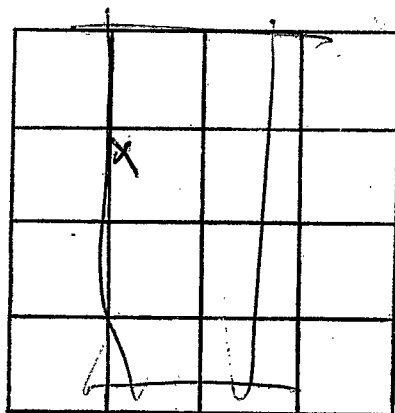

SECTION 24

Please indicate well location X.

ADDITIONAL INFORMATION

If more than one screen, show locations of each on sketch.