

WILKINSON

T 2003

6-2-78

MISSISSIPPI BOARD OF WATER COMMISSIONERS
416 North State Street
Jackson, Mississippi 39201

WATER WELL DRILLERS LOG

June 2 1978 Beaver Well Co. Wilkerson
date well completed firm name county well located

LANDOWNER:	description of formations encountered	from	to
<u>Al Jarreau</u>			
<u>address unknown</u> (mailing address)	<u>Red clay</u>	<u>0</u>	<u>27</u>
	<u>Red sand</u>	<u>27</u>	<u>38</u>
	<u>Gravel & sand</u>	<u>38</u>	<u>107</u>
	<u>White chert</u>	<u>107</u>	<u>155</u>
	<u>Red sand</u>	<u>155</u>	<u>178</u>
	<u>Coarse sand</u>		
	<u>Some pebbles</u>	<u>178</u>	<u>190</u>
WELL LOCATION: sec. <u>25</u> T <u>1</u> N R <u>1</u> E <u>2</u> miles <u>South</u> of <u>Centerville</u> (distance) (direction) (nearest town)			
WELL PURPOSE: <u>Comp</u> (home, irrigation, municipal, industrial)			
WELL COMPLETION DATA:			
(1) diameter (inches) <u>4"</u>			
(2) total depth (feet) <u>190</u>			
(3) static water level (feet) <u>76</u> below above top of ground.			
(4) casing <u>plastic bottom</u> (material) (depth)			
<u> </u> if telescope see back. (size)			
(5) screen <u>10'</u> <u>180'</u> (length) (depth to top)			
<u>4"</u> <u>plastic</u> (size) (material)			
(6) pump <u>3 sub</u> <u>15</u> (HP) (yield gpm)			
<u>split</u> (type power)			
(7) electric log <u>no</u> (yes or no)			
<u> </u> (organization running log)			
(8) how well bottom plugged <u>Washer plug</u>			
DRILLERS REMARKS: <u>well made dry</u> <u>at 107ft</u>			


RECEIVED

AUG 28 1978

MISS. BD. OF WATER COMM

If well telescopes please sketch and show depths.

GROUND LEVEL

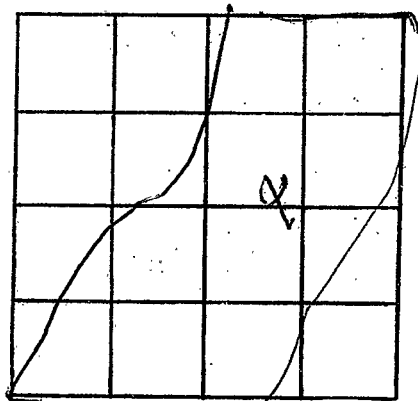

SECTION 25

Please indicate well location X.

ADDITIONAL INFORMATION

If more than one screen,
show locations of each on sketch.