

WILKINSON
T 2004
6-11-79

MISSISSIPPI
BOARD OF WATER COMMISSIONERS
416 North State Street
Jackson, Mississippi 39201

WATER WELL DRILLERS LOG

June 11 1979 Reynolds Sei Wilkerson
date well completed firm name county well located

LANDOWNER:
Mrs. O. B. Bergeson
At Centerville
(mailing address)

description of formations encountered	from	to
<u>Red sand shale</u>	<u>0</u>	<u>18</u>
<u>Red sand</u>	<u>18</u>	<u>70</u>
<u>Coarse sand</u>	<u>70</u>	<u>83</u>
<u>gravel</u>		

WELL LOCATION:
sec. 49 T 1 N R 1 E
5 miles South of Centerville
(distance) (direction) (nearest town)

WELL PURPOSE: home
(home, irrigation, municipal, industrial)


- WELL COMPLETION DATA:
- (1) diameter (inches) 4"
 - (2) total depth (feet) 83
 - (3) static water level (feet) 54 below top of ground.
 - (4) casing plastic bottom
(material) (depth)
(size) if telescope see back.
 - (5) screen 5' 78'
(length) (depth to top)
4" plastic
(size) (material)
 - (6) pump 1/2 10
(HP) (yield gpm)
elect
(type power)
 - (7) electric log no
(yes or no)
(organization running log)

(8) how well bottom plugged
wooden plug
DRILLERS REMARKS:

DEPT. OF NATURAL RESOURCES
BUREAU OF LAND & WATER RESOURCES
JAN 22 1980
RECEIVED

If well telescopes please sketch and show depths.

GROUND LEVEL

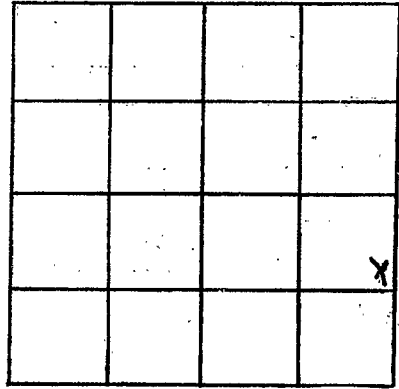

SECTION 49

Please indicate well location X.

ADDITIONAL INFORMATION

If more than one screen, show locations of each on sketch.