

WILKINSON

T 2005

6-11-80

MISSISSIPPI
 BOARD OF WATER COMMISSIONERS
 416 North State Street
 Jackson, Mississippi 39201

WATER WELL DRILLERS LOG

6-11-80 date well completed


1980 Fitzgerald Well Dr firm name

Wilkinson county well located

LANDOWNER:	description of formations encountered	from	to
Cliff Rogers	Red clay	0	20
R.D. Cantrellville (mailing address)	Red sand	20	40
WELL LOCATION:	White Blue clay	40	100
sec. 6-T-1(N) R-1(E) 3 miles SW of Cantrellville (distance) (direction) (nearest town)	Coarse sand & gravel	100	120
WELL PURPOSE: observation (home, irrigation, municipal, industrial)			
WELL COMPLETION DATA:			
(1) diameter (inches) 4			
(2) total depth (feet) 120			
(3) static water level (feet) No below top of ground.			
(4) casing PVC 112 (material) (depth)			
4 (size) if telescope see back.			
(5) screen 8 112 (length) (depth to top)			
4 (size) PVC (material)			
(6) pump 1/2 10 (HP) (yield gpm)			
Ebe (type power)			
(7) electric log (yes or no)			
(organization running log)			
(8) how well bottom plugged Sand			
DRILLERS REMARKS:	DEPT. OF NATURAL RESOURCES BUREAU OF LAND & WATER RESOURCES	SEP 8 - 1980	RECEIVED

If well telescopes please sketch and show depths.

GROUND LEVEL

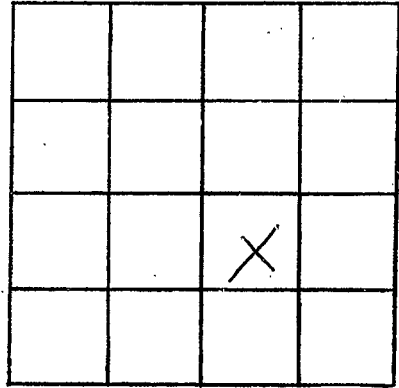

SECTION 6

Please indicate well location X.

ADDITIONAL INFORMATION

If more than one screen, show locations of each on sketch.