

MISSISSIPPI DEPARTMENT OF NATURAL RESOURCES

Bureau of Land and Water Resources

Southport Mall

P.O. Box 10631

Jackson, Mississippi 39209

WATER WELL DRILLERS LOG

Wilkinson
T 2006
1-25-80

Jan 25 1980 Acorns Well Co Wilkinson
 date well completed firm name county well located

LANDOWNER:
Joe B Lion
Centerville
 (mailing address)

description of formations encountered	from	to
<u>blue clay</u>	<u>0</u>	<u>18</u>
<u>white sand</u>	<u>18</u>	<u>63</u>
<u>hard blue chalk</u>	<u>63</u>	<u>198</u>
<u>coarse sand</u>	<u>198</u>	<u>216</u>

WELL LOCATION:
 sec. 42 T 1 (N) R 1 (E)
6 miles W.S.W. of Centerville
 (distance) (direction) (nearest town)

WELL PURPOSE: house
 (home, irrigation, municipal, industrial)

WELL COMPLETION DATA:

(1) diameter (inches) 4"

(2) total depth (feet) 216

(3) static water level (feet) 65 below above top of ground.

(4) casing plastic, bottom
 (material) (depth)

 if telescope see back.
 (size)

(5) screen 10', 206'
 (length) (depth to top)

4", plastic
 (size) (material)

(6) pump weather's
 (HP) (yield gpm)

elect
 (type power)

(7) electric log no
 (yes or no)

 (organization running log)

(8) how well bottom plugged
wooden plug

DRILLERS REMARKS:


DEPT. OF NATURAL RESOURCES
 BUREAU OF LAND & WATER RESOURCES

NOV 14 1980

RECEIVED

If well telescopes please sketch and show depths.

GROUND LEVEL

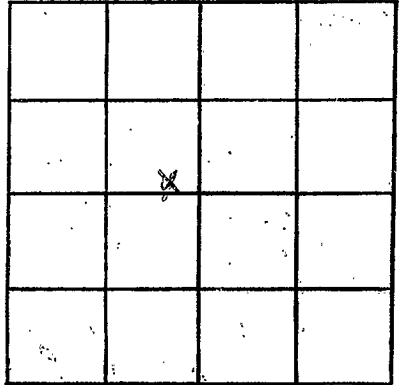

SECTION 112

Please indicate well location X.

ADDITIONAL INFORMATION

If more than one screen,
show locations of each on sketch.