

Wilburson
T 2009

MISSISSIPPI DEPARTMENT OF NATURAL RESOURCES
Bureau of Land and Water Resources
Southport Mall
P.O. Box 10631
Jackson, Mississippi 39209
WATER WELL DRILLERS LOG

Sept 24 1982 Reems Well Inc Wilburson
date well completed firm name county well located

LANDOWNER:
M. W. King
Woodville
(mailing address)

description of formations encountered	from	to
	<u>Red sandy clay</u>	<u>0</u>
<u>Red sand</u>	<u>18</u>	<u>90</u>
<u>plag ground sand</u>	<u>90</u>	<u>104</u>

WELL LOCATION:
sec. 23 T 1 N R. 1E
5 1/2 miles SE of Woodville
(distance) (direction) (nearest town)

WELL PURPOSE: house
(home, irrigation, municipal, industrial)

- WELL COMPLETION DATA:
- (1) diameter (inches) 4"
 - (2) total depth (feet) 104
 - (3) static water level (feet) 80 below above top of ground.
 - (4) casing plastic bottom
(material) (depth)
 - _____ if telescope see back.
(size)
 - (5) screen 5' 99'
(length) (depth to top)
 - 4" plastic
(size) (material)
 - (6) pump 1/2 10
(HP) (yield gpm)
 - 1/2
(type power)
 - (7) electric log no
(yes or no)
 - _____ (organization running log)

(8) how well bottom plugged
back wash

DRILLERS REMARKS:


DEPT. OF NATURAL RESOURCES
BUREAU OF LAND & WATER RESOURCES

FEB 24 1983

RECEIVED

If well telescopes please sketch and show depths.

GROUND LEVEL

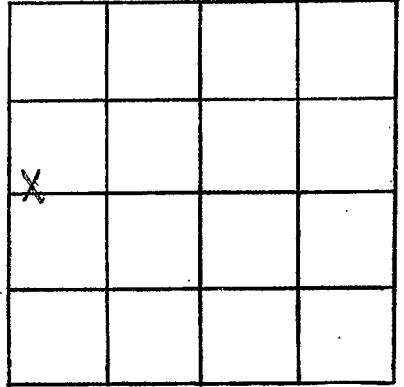

SECTION 23

Please indicate well location X.

ADDITIONAL INFORMATION

If more than one screen,
show locations of each on sketch.