

MISSISSIPPI DEPARTMENT OF NATURAL RESOURCES

Bureau of Land and Water Resources

Southport Mall

P.O. Box 10631

Jackson, Mississippi 39209

WATER WELL DRILLERS LOG

Wilkinson
T 2000

Oct 1 1982 News Well Dr Wilkinson
date well completed firm name county well located

LANDOWNER:	description of formations encountered	from	to
<u>Selvin Grimes</u> <u>Woodville</u> (mailing address)	<u>Clay</u> <u>Red Sand</u> <u>Chalk</u> <u>Sand (red)</u> <u>Red Granite Sand</u>	<u>0</u> <u>19</u> <u>60</u> <u>120</u> <u>135</u>	<u>19</u> <u>60</u> <u>120</u> <u>135</u> <u>143</u>
WELL LOCATION: sec. <u>9</u> T <u>1</u> N R <u>1</u> E <u>4</u> miles <u>S-SE</u> of <u>Woodville</u> (distance) (direction) (nearest town)			
WELL PURPOSE: <u>house</u> (home, irrigation, municipal, industrial)			
WELL COMPLETION DATA:			
(1) diameter (inches) <u>4"</u>			
(2) total depth (feet) <u>143</u>			
(3) static water level (feet) <u>100</u> below top of ground			
(4) casing <u>plastic, bottom</u> (material) (depth)			
_____ if telescope see back. (size)			
(5) screen <u>5'</u> , <u>138'</u> (length) (depth to top)			
_____ <u>plastic</u> (size) (material)			
(6) pump <u>1/2</u> <u>10</u> (HP) (yield gpm)			
_____ <u>elect</u> (type power)			
(7) electric log <u>no</u> (yes or no)			
_____ (organization running log)			
(8) how well bottom plugged <u>back wash</u>			
DRILLERS REMARKS: _____			


DEPT. OF NATURAL RESOURCES
BUREAU OF LAND & WATER RESOURCES

FEB 24 1983

RECEIVED

If well telescopes please sketch and show depths.

GROUND LEVEL

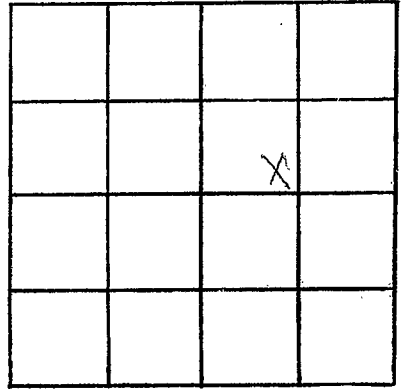

SECTION 9

Please indicate well location X.

ADDITIONAL INFORMATION

If more than one screen,
show locations of each on sketch.