

Wilkinson
T 204

MISSISSIPPI DEPARTMENT OF NATURAL RESOURCES
Bureau of Land and Water Resources
Southport Mall
P.O. Box 10631
Jackson, Mississippi 39209
WATER WELL DRILLERS LOG

April 2 1983 Reeves Well Serv. Wilkinson
date well completed firm name county well located

LANDOWNER:
Richard Hagan
Centerville
(mailing address)

description of formations encountered	from	to
<u>clay</u>	<u>0</u>	<u>22</u>
<u>sand</u>	<u>22</u>	<u>72</u>
<u>blue & white clay</u>	<u>72</u>	<u>115</u>
<u>sand</u>	<u>115</u>	<u>137</u>

WELL LOCATION:
sect 36 T 1 N R 1 E
3 miles South of Centerville
(distance) (direction) (nearest town)

WELL PURPOSE: same
(home, irrigation, municipal, industrial)

- WELL COMPLETION DATA:
- (1) diameter (inches) 4"
 - (2) total depth (feet) 137 feet
 - (3) static water level (feet) 60 below above top of ground.
 - (4) casing plastic, Bottom
(material) (depth)
 - K if telescope see back.
(size)
 - (5) screen 5', 132'
(length) (depth to top)
 - 4", plastic
(size) (material)
 - (6) pump by others
(HP) (yield gpm)
 - Elect.
(type power)
 - (7) electric log NO
(yes or no)
 - ✓
(organization running log)

(8) how well bottom plugged
Back wash


DRILLERS REMARKS:
✓

DEPT. OF NATURAL RESOURCES
BUREAU OF LAND & WATER RESOURCES

JUN 17 1983
RECEIVED

If well telescopes please sketch and show depths.

GROUND LEVEL

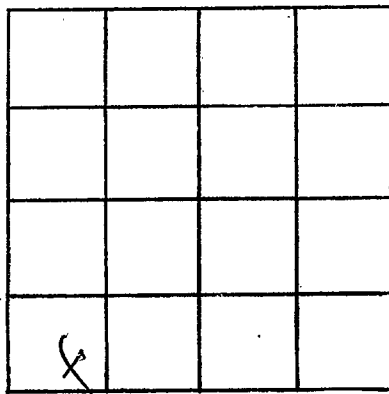

SECTION 36

Please indicate well location X.

ADDITIONAL INFORMATION

If more than one screen, show locations of each on sketch.