

MISSISSIPPI DEPARTMENT OF NATURAL RESOURCES

Bureau of Land and Water Resources

Southport Mall

P.O. Box 10631

Jackson, Mississippi 39209

WATER WELL DRILLERS LOG

TOM GRIFFITH

PLUMBING & WELL SERVICE, INC. *Wilkinson*

*Wilkins*  
*T 2012*

*11-4-83*  
date well completed

*320 WAYSON AVE.*  
COLUMBIA, MS 39429

county well located

LANDOWNER: *J H J Drilling*  
*Rt-4, Box 618*  
*Ellisville, MS 39437*  
(mailing address)

description of formations encountered	from	to
<i>Sand &amp; Gravel</i>	<i>0</i>	<i>100</i>
<i>Chalk</i>	<i>100</i>	<i>260</i>
<i>Sand</i>	<i>260</i>	<i>300</i>

WELL LOCATION:  
sec. *32* T *1* N R *1* E  
*1* miles *E* of *Centerville*  
(distance) (direction) (nearest town)

WELL PURPOSE: *Oil Location*  
(home, irrigation, municipal, industrial)

WELL COMPLETION DATA:

- (1) diameter (inches) *4"*
- (2) total depth (feet) *300'*
- (3) static water level (feet) *100'* below top of ground
- (4) casing *Steel* *240'*  
(material) (depth)  
*N/A* if telescope see back.  
(size)
- (5) screen *60'* *240'*  
(length) (depth to top)  
*4 3/8"* *Slotted Steel*  
(size) (material)
- (6) pump *N/A* *70*  
(HP) (yield gpm)  
*air lift*  
(type power)
- (7) electric log *NO*  
(yes or no)  
*N/A*  
(organization running log)
- (8) how well bottom plugged *wedged*


DRILLERS REMARKS:

DEPT. OF NATURAL RESOURCES  
BUREAU OF LAND & WATER RESOURCES

RECEIVED  
DEC 15 1983

If well telescopes please sketch and show depths.

GROUND LEVEL

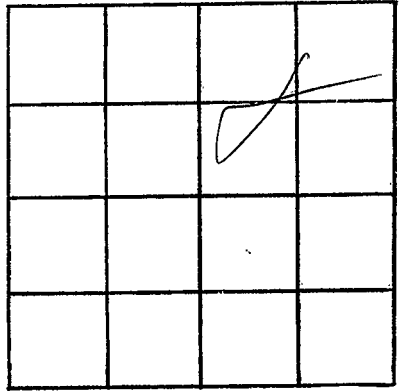

SECTION 32

Please indicate well location X.

ADDITIONAL INFORMATION

If more than one screen,  
show locations of each on sketch.