

MISSISSIPPI DEPARTMENT OF NATURAL RESOURCES

Bureau of Land and Water Resources

Southport Mall

P.O. Box 10631

Jackson, Mississippi 39209

WATER WELL DRILLERS LOG

Wilkinson
T 2013
6-26-85

L

6-26 1985
date well completed

Fitzgerald Well Drilling
firm name

Wilkinson
county well located


LANDOWNER:	description of formations encountered	from	to
Morris McKey	Red clay	0	20
R.R. Centerville, ms. (mailing address)	Red sand	20	90
WELL LOCATION: sec 31 T 2 N R 1 E 4 miles SW of Centerville (distance) (direction) (nearest town) WELL PURPOSE: Home (home, irrigation, municipal, industrial) WELL COMPLETION DATA: (1) diameter (inches) 4 (2) total depth (feet) 110 (3) static water level (feet) 70 below above top of ground. (4) casing PVC, 100 (material) (depth), 4 (size) if telescope see back. (5) screen 10, 100 (length) (depth to top), 4 (size), PVC (material) (6) pump 1/2 (HP), 10 (yield gpm), Elec (type power) (7) electric log no (yes or no) (organization running log) (8) how well bottom plugged Level Shok	Coarse sand & gravel	90	110
DRILLERS REMARKS:			

RECEIVED
JUL 22 1985

Department of Natural Resources
Bureau of Land & Water Resources

If well telescopes please sketch and show depths.

GROUND LEVEL

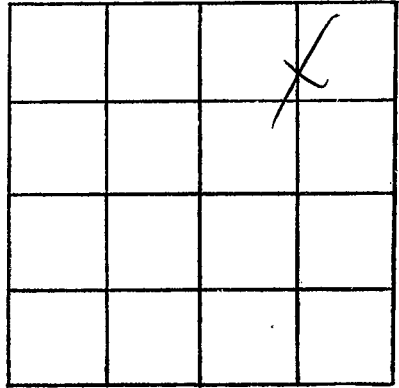

SECTION 31

Please indicate well location X.

ADDITIONAL INFORMATION

If more than one screen,
show locations of each on sketch.