

MISSISSIPPI DEPARTMENT OF NATURAL RESOURCES

Bureau of Land and Water Resources

P.O. Box 10631

Jackson, Mississippi 39209

WATER WELL DRILLERS LOG

COUNTY WELL LOCATED <i>Waltham</i>	
WELL NUMBER T	CODED
2015	
DATE WELL COMPLETED 5-31-89	

3250

PERMIT NUMBER
NAME OF DRILLING FIRM Fitzgerald Well Serv

NAME & MAILING ADDRESS OF LANDOWNER <i>Rollins Timber Co</i>			
<i>P.O. Box Centerville MS.</i>			
WELL LOCATION:	SEC	TOWNSHIP	RANGE
	2	1 N	1 W
DISTANCE	DIRECTION	NEAREST TOWN	
1 Miles	SSW	<i>Centerville</i>	
OTHER LANDMARK			
WELL PURPOSE: Home, Irrigation, Municipal, Industrial, Fish Pond, etc. Sprinkler system - Pond			

PUMP DATA		
PUMP TYPE (Circle One): Submersible, Turbine, Jet, Flowing Well, Other (Describe) _____		
POWER TYPE (Circle One): Electric, Tractor, Diesel, Gasoline, Butane, Other (Describe) _____		
Pump Capacity (GPM)	No. of Stages	Setting Depth
50	9	170 FT.
PUMP TEST		
Well yielded 50 GPM with a drawdown of 25 ft. after 2 hours of pumping		

WELL DATA		
Well Depth 186	Casing Diameter (in.) 4	Casing Length (ft.) 151
Type of Casing NUC	Hole Depth 186	Depth to Static Water Level 65
TYPE OF COMPLETION: (Circle One or More): <input checked="" type="checkbox"/> Gravel Packed, <input type="checkbox"/> Underreamed, <input type="checkbox"/> Telescoped, <input type="checkbox"/> Natural Development, <input type="checkbox"/> Open Hole, <input type="checkbox"/> Other (Describe) _____		
Top of Lap Pipe or Reduction in Casing FEET IF TELESCOPED OR MORE THAN ONE SCREEN: USE BACK PAGE		

LOG DATA	
TYPE OF LOG RUN (Circle One): Electric, Gamma Ray, Density, Sonic, <input checked="" type="checkbox"/> No Log Run, Neutron, Other (Describe) _____	
Name of Organization Running Log	

SCREEN DATA		
Diameter - Inches 4	Length - Feet 35	Slot Size - Inches .014
Screen Type NUC	Depth to Bottom - Feet 186	



GEOLOGIC DATA (Office Use Only)			
Surface Elev.	Geologic Unit	Unit Thickness	Depth to Top
Subs. SWL	Date	Analysis	Aquifer Test
Driller's Remarks			

DESCRIPTION OF FORMATIONS ENCOUNTERED	FROM	TO	FORMATIONS (Continued)	FROM	TO
<i>clay</i>	0	20	RECEIVED JUL 07 1989 Department of Natural Resources Bureau of Land & Water Resources		
<i>Red Sand</i>	20	90			
<i>Coarse Sand</i>	90	110			
<i>Fine Sand</i>	110	125			
<i>Coarse sand</i>	115	125			
<i>white chalky</i>	125	170			
<i>Coarse Sand</i>	170	186			

IF MORE SPACE IS NEEDED, USE BACK

If well telescopes please sketch and show depths.

GROUND LEVEL

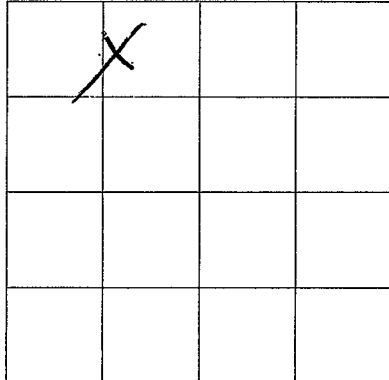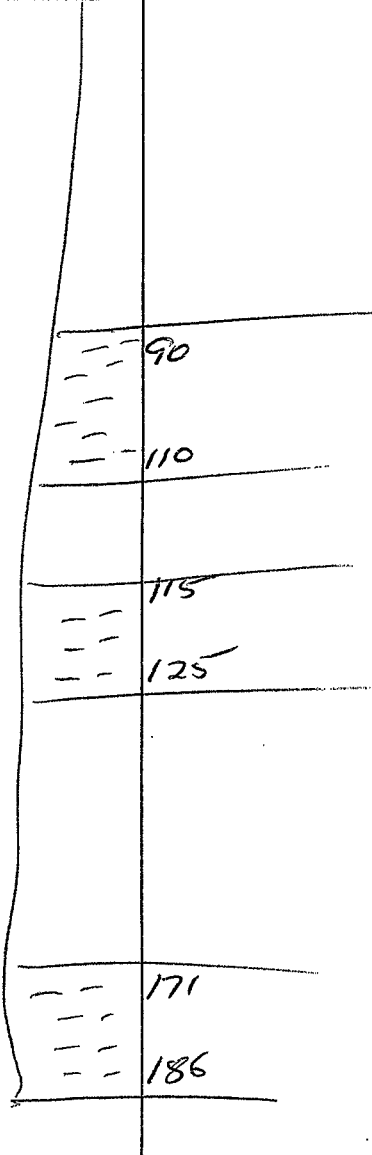

SECTION 2

Please indicate well location X.

ADDITIONAL INFORMATION

Lined area for providing additional information.

If more than one screen, show location of each on sketch.