

MISSISSIPPI DEPARTMENT OF NATURAL RESOURCES

Bureau of Land and Water Resources

P.O. Box 10631

Jackson, Mississippi 39209

WATER WELL DRILLERS LOG

COUNTY WELL LOCATED WILKINSON	
WELL NUMBER 7	CODED
2019	
DATE WELL COMPLETED 3/13/91	

PERMIT NUMBER 0-402
NAME OF DRILLING FIRM Tom GRIFFITH
WATER WELL, Inc.

NAME & MAILING ADDRESS OF LANDOWNER UNOCAL CORPORATION			
P.O. Box 4531			
Houston, TX 77210-4531			
WELL LOCATION:	SEC	TOWNSHIP	RANGE
	45	1 S	1 E
DISTANCE	DIRECTION	NEAREST TOWN	
7 Miles	S	Centerville	
OTHER LANDMARK			
WELL PURPOSE: Home, Irrigation, Municipal, Industrial, Fish Pond, etc. BB SUPPLY			

PUMP DATA		
PUMP TYPE (Circle One): <u>Submersible</u> , Turbine, Jet, Flowing Well, Other (Describe) _____		
POWER TYPE (Circle One): <u>Electric</u> , Tractor, Diesel, Gasoline, Butane, Other (Describe) _____		
Pump Capacity (GPM) 90	No. of Stages	Setting Depth 210 FT.
PUMP TEST		
Well yielded 90 GPM with a drawdown of _____ ft. after _____ hours of pumping		


WELL DATA		
Well Depth 350'	Casing Diameter (In.) 4"	Casing Length (Ft.) 220'
Type of Casing PVC	Hole Depth 250'	Depth to Static Water Level 115'
TYPE OF COMPLETION: (Circle One or More): <u>Natural Development</u> , Gravel Packed, Underreamed, Telescoped, Open Hole, Other (Describe) _____		
Top of Lap Pipe or Reduction in Casing FEET IF TELESOPED OR MORE THAN ONE SCREEN: USE BACK PAGE		

LOG DATA	
TYPE OF LOG RUN (Circle One): Electric, Gamma Ray, Density, Sonic, <u>No Log Run</u> , Neutron, Other (Describe) _____	
Name of Organization Running Log	

SCREEN DATA		
Diameter - Inches 4"	Length - Feet 20'	Slot Size - Inches 20# - .025 10# - .013
Screen Type PVC Slot	Depth to Bottom - Feet 250'	

GEOLOGIC DATA (Office Use Only)			
Surface Elev.	Geologic Unit	Unit Thickness	Depth to Top
Subs. SWL	Date	Analysis	Aquifer Test
Driller's Remarks			

DESCRIPTION OF FORMATIONS ENCOUNTERED	FROM	TO	FORMATION DISCONTINUED FROM
Clay	0	20	
Red Sand	20	80	
Red Sand	80	90	
Gravel	90	105	
Clay	105	120	
Clay	120	130	
Rock	130	132	
Clay (hard)	132	160	
In/out of Rocks	160	170	
Good Sand	170	180	
Good Sand	180	250	

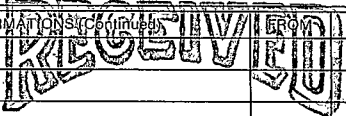


APR 17 1991

Dept. of Environmental Quality
Bureau of Land & Water Resources

IF MORE SPACE IS NEEDED, USE BACK

If well telescopes please
sketch and show depths.

GROUND LEVEL

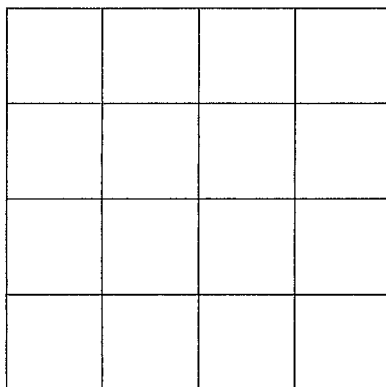

SECTION _____

Please indicate well location X.

ADDITIONAL INFORMATION

If more than one screen,
show location of each on sketch.