

CODED

WATER WELL DRILLERS LOG

5-19-65
 Date: 8-19, 1965, Driller: Merritt Drilling County Winston
 (Name)

(1) Owner of Land: SMITH COOK
 (Name)
RT #2 STURGIS, MISS
 (Address)
 (2) Location: 151612
 1/4, 1/4, Sec. T R
10 miles NORTH of LOUISVILLE
 (distance) (direction) (Nearest Town)
 (3) Topography: Hilly
 (Hilly) (Flat) (Level)
 (4) Purpose of Well: DOMESTIC
 (Domestic Irrigation
 Municipal, Industrial, Other)


Description & Color of Materials Sand, Clay, Red Clay, Shell, etc.	Thick- ness Feet	Depth Feet
<u>Red CLAY</u>	<u>0</u>	<u>10</u>
<u>RED SAND</u>	<u>10</u>	<u>20</u>
<u>Mixed CLAY & SAND</u>	<u>20</u>	<u>70</u>
<u>TAN SAND</u>	<u>70</u>	<u>113</u>

Information upon completion of well:

(1) Diameter 2 inches.
 (2) Total Depth 113 feet.
 (3) Water Level 95 feet below top of ground.
 (4) Cased to 105, Size 2
 (5) Screen: Size 1 1/4, Length 6'
 (6) Were any formations sealed against pollution?
 _____ yes, no.

If YES depth of formation _____
 Why _____

Drillers Remarks: _____

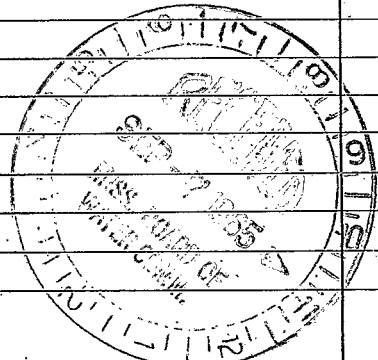

(Use Back Side)

Well No. _____

