

WINSTON
A 2
2-28-74

MISSISSIPPI
BOARD OF WATER COMMISSIONERS CODED
416 North State Street
Jackson, Mississippi 39201

WATER WELL DRILLERS LOG


2-28 date well completed 1974 G. H. McDaniel firm name Winston county well located

LANDOWNER: <u>Frankie J. Frazier</u> <u>Louisville Miss</u>	description of formations encountered	from	to
(mailing address)	<u>red clay</u>	0	15
WELL LOCATION: sec. <u>33</u> T. <u>16</u> N. R. <u>12</u> E <u>5 1/2</u> miles <u>north</u> of <u>Louisville</u> (distance) (direction) (nearest town)	<u>lignite</u>	15	16
WELL PURPOSE: <u>Home</u> (home, irrigation, municipal, industrial)	<u>gray clay</u>	16	180
WELL COMPLETION DATA: (1) diameter (inches) <u>2"</u> (2) total depth (feet) <u>230</u> (3) static water level (feet) <u>155</u> below top of ground. (4) casing <u>steel</u> <u>168'</u> (material) (depth) <u>2"</u> if telescope see back. (size) (5) screen <u>5'</u> <u>225-230</u> (length) (depth to top) <u>1/2</u> <u>(60) SS.</u> (size) (material) (6) pump <u>3/4</u> <u>5</u> (HP) (yield gpm) <u>electric</u> (type power) (7) electric log <u>no</u> (yes or no) (organization running log) (8) how well bottom plugged	<u>fine sand</u>	180	203
DRILLERS REMARKS:	<u>CODED</u> <u>gray sand</u>	203	230

APR 2 1974
MISS. BD. OF WATER COMMISSIONERS

If well telescopes please sketch and show depths.

GROUND LEVEL

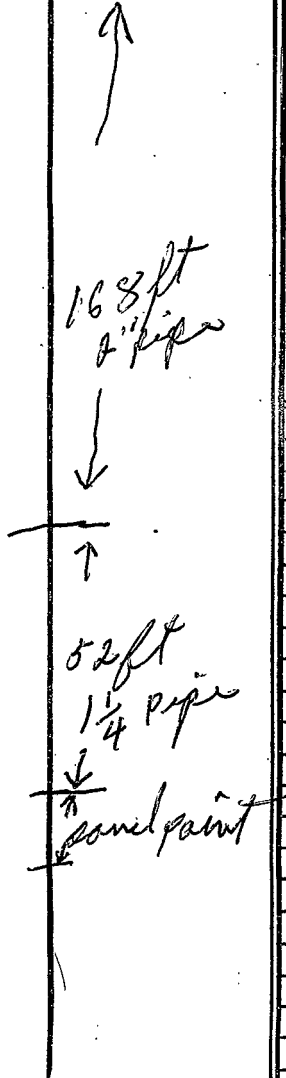

			X

SECTION 33

Please indicate well location X.

ADDITIONAL INFORMATION

If more than one screen, show locations of each on sketch.