

WINSTON
A 3
2-22-74

MISSISSIPPI
 BOARD OF WATER COMMISSIONERS
 416 North State Street
 Jackson, Mississippi 39201

CODED

WATER WELL DRILLERS LOG

2-22 1974 *J. H. McDonald* *Winston*
 date well completed firm name county well located

LANDOWNER: *Benny Farmer*

description of formations encountered

from to

Louisville, Miss
 (mailing address)

red clay

0 20

lignite

20 21

WELL LOCATION:

sec. *23* T. *16* (N) R. *12* (E)

gray clay

21 180

5 miles *North* of *Louisville*
 (distance) (direction) (nearest town)

fine sand

180 200

WELL PURPOSE: *Home*
 (home, irrigation, municipal, industrial)

gray sand
CODED

200 221

WELL COMPLETION DATA:

(1) diameter (inches) *2"*

(2) total depth (feet) *221*

(3) static water level (feet) *140* below above top of ground.

(4) casing *steel*, *168'*
 (material) (depth)

2" If telescope see back.
 (size)

(5) screen *5'*, *221-216*
 (length) (depth to top)

1/4", *SS*
 (size) (material)

(6) pump *1*, *3*
 (HP) (yield gpm)

electric
 (type power)

(7) electric log *no*
 (yes or no)

(organization running log)

(8) how well bottom plugged

DRILLERS REMARKS:


REGISTERED
PAID

APR - 2 1974

MISS. BD OF WATER COMMISSIONERS

If well telescopes please sketch and show depths.

GROUND LEVEL

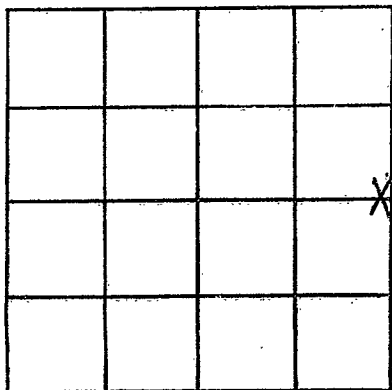

SECTION 33

Please indicate well location X.

ADDITIONAL INFORMATION

If more than one screen, show locations of each on sketch.