

Winston  
 A 2000  
 6-21-76

MISSISSIPPI  
 BOARD OF WATER COMMISSIONERS  
 416 North State Street  
 Jackson, Mississippi 39201

WATER WELL DRILLERS LOG

6-21 1976 J. H. McDonald Winston  
 date well completed firm name county well located

LANDOWNER: Winnie Haines  
 Louisville Miss

description of formations encountered	from	to
Red clay	0	10
pipe clay	10	30
yellow sand	30	58

(mailing address)

WELL LOCATION:

sec. 15 T. 16(N) R. 12(E)  
 S W  
 9 miles south of Louisville  
 (distance) (direction) (nearest town)

WELL PURPOSE: Home  
 (home, irrigation, municipal, industrial)

WELL COMPLETION DATA:

- (1) diameter (inches) 2"
- (2) total depth (feet) 58
- (3) static water level (feet) 45 below top of ground.
- (4) casing PVC 54 (material) (depth)  
 2" if telescope see back. (size)
- (5) screen 8" x 4" 58-54 (length) (depth to top)  
 1/4 inch 10 gal 55 (size) (material)
- (6) pump 1 (HP) 10 (yield gpm)  
 electric (type power)
- (7) electric log no. (yes or no)

(organization running log)

(8) how well bottom plugged


DRILLERS REMARKS:

RECEIVED  
 SEP 15 1976

MISS. BU. OF WATER COMMISSION

If well telescopes please sketch and show depths.

GROUND LEVEL

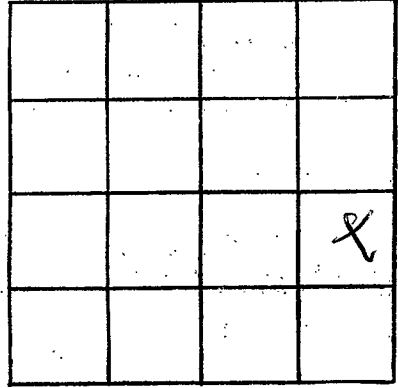

SECTION 15

Please indicate well location X.

ADDITIONAL INFORMATION

If more than one screen, show locations of each on sketch.