

5 136
CODED

MISSISSIPPI
BOARD OF WATER COMMISSIONERS
416 North State Street
Jackson, Mississippi 39201

WATER WELL DRILLERS LOG

5-3
date well completed

19 68 J. F. McDonald
firm name

Winston
county well located

LANDOWNER:

Robby Gregory
(mailing address)

description of formations encountered

from to

Yellow Sand 0' 41'
Red Sand 41' 24'
yellow sand 24' 46'

WELL LOCATION:

sec. 17 T. 16 N. R. 13 E. S. W.
9 1/2 miles NE of Louisville
(distance) (direction) (nearest town)

WELL PURPOSE:

HOME
(home, irrigation, municipal, industrial)

WELL COMPLETION DATA:

(1) diameter (inches) 2 1/2

(2) total depth (feet) 46' 10"

(3) static water level (feet) below top of ground

(4) casing 42' (material), 46' (depth)

(size) if telescope see back.

(5) screen 4' (length), (depth to top)

(size) (material)

(6) pump 1 1/2 HP (yield gpm)

Electric (type power)

(7) electric log (yes or no)

(organization running log)

(8) how well bottom plugged


MAY 10 1968

DRILLERS REMARKS:

MISS. BD. OF
WATER COMM.

If well telescopes please sketch and show depths.

GROUND LEVEL

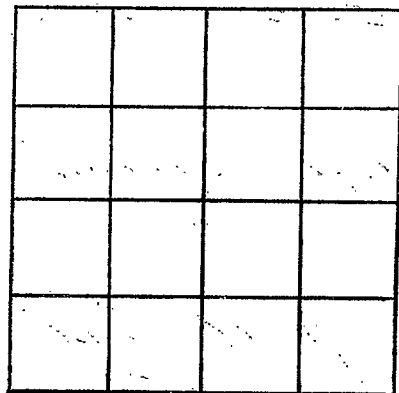

SECTION _____

Please indicate well location X.

ADDITIONAL INFORMATION

If more than one screen,
show locations of each on sketch.