

WINSTON
 B *2000*
 8-18-78

MISSISSIPPI
 BOARD OF WATER COMMISSIONERS
 416 North State Street
 Jackson, Mississippi 39201

WATER WELL DRILLERS LOG *Winston*

8-18 19 *76* *H McDonald* *Winston*
 date well completed firm name county well located

LANDOWNER: *S.P. Tate*
Louisville Miss
 (mailing address)
 WELL LOCATION:
 sec *27 T 16 N R 13 E*
7 miles *N.E.* of *Louisville*
 (distance) (direction) (nearest town)

description of formations encountered	from	to
<i>red clay</i>	<i>0</i>	<i>22</i>
<i>sand & pipe clay</i>	<i>25</i>	<i>33</i>
<i>white sand</i>	<i>33</i>	<i>39</i>

WELL PURPOSE:
 (home, irrigation, municipal, industrial)

WELL COMPLETION DATA:

(1) diameter (inches) *2*

(2) total depth (feet) *38*

(3) static water level (feet) *31* below above top of ground.

(4) casing *PVC* *35*
 (material) (depth)
2" if telescope see back.
 (size)

(5) screen *3'* *38* *35*
 (length) (depth to top)
1/4" *10 slot SS*
 (size) (material)

(6) pump *1* *3*
 (HP) (yield gpm)

electric
 (type power)

(7) electric log *no*
 (yes or no)

(organization running log)

(8) how well bottom plugged


DRILLERS REMARKS:

RECEIVED
 OCT 24 1978

MISS. BD. OF WATER COMMISSIONERS

If well telescopes please sketch and show depths.

GROUND LEVEL

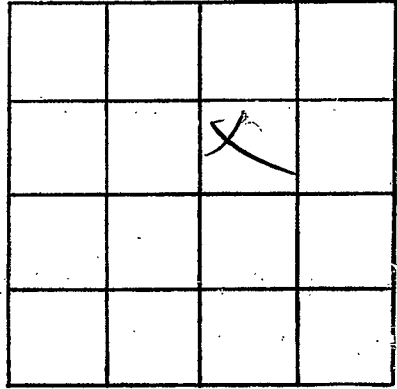

SECTION 27

Please indicate well location X.

ADDITIONAL INFORMATION

If more than one screen, show locations of each on sketch.