

CODED

5 13T

WINSTON  
D3  
11-67

MISSISSIPPI  
BOARD OF WATER COMMISSIONERS  
416 North State Street  
Jackson, Mississippi 39201

WATER WELL DRILLERS LOG

11-14-67 date well completed  
J. H. McDonald firm name  
Winston county well located

LANDOWNER:

description of formations encountered

from to

John F. Clark  
(mailing address)

Red & White clay  
~~to top~~ 0' 40'  
Shag clay 40' 168'  
Fine Shag sand 168' 200'

WELL LOCATION:

sec. 12 15N R-11E  
6 miles NW of Louisville  
(distance) (direction) (nearest town)

WELL PURPOSE: Home  
(home, irrigation, municipal, industrial)

WELL COMPLETION DATA:

- (1) diameter (inches) 2"
- (2) total depth (feet) 200'
- (3) static water level (feet) 168' (below above top of ground)
- (4) casing 168' 200' (material) (depth)  
NONE (size) if telescope see back.
- (5) screen OPEN (length) (depth to top)  
(size) (material)
- (6) pump 3/4 HP 4 gpm (HP) (yield gpm)  
Electric (type power)
- (7) electric log NO (yes or no)  
(organization running log)
- (8) how well bottom plugged


MAY 10 1968

MISS. BD. OF  
WATER COMM.

DRILLERS REMARKS:

If well telescopes please  
sketch and show depths.

GROUND LEVEL

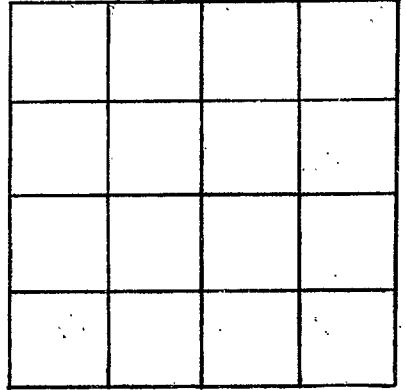

SECTION \_\_\_\_\_

Please indicate well location X.

ADDITIONAL INFORMATION

If more than one screen,  
show locations of each on sketch.