

D5 137 CODED

WATER WELL DRILLERS LOG

Date: 9-9-60, 1960, Driller: L. K. Merritt County: Winston (Name)

(1) Owner of Land: J. L. McKay (Name)
R. F. D. Lenoirville Miss (Address)
(2) Location: 3 15 11 1/4, 1/4, Sec. T. R.
7 miles N/W of Lenoirville (distance, direction, Nearest Town)
(3) Topography: (Hilly, Flat, Level)
(4) Purpose of Well: Domestic (Domestic Irrigation, Municipal, Industrial, Other)


Table with 3 columns: Description & Color of Materials (Sand, Clay, Red Clay, Shell, etc.), Thickness (Feet), Depth (Feet).
Rows include: Old Surgeon Clay (0-9), Boy Clay (9-16), Hard soapstone (16-30), Hard lignite (30-34), Soft blue clay (34-80), Hard blue clay (80-83), Soft lignite (83-85), Med. Hard light gray clay (85-112), Med. top dark gray clay (112-120), Gray clay + fine sand (120-200), Dark clay, shale + trace of sand (200-235), Fine gray sand & silt (235-255), Med. Fine gray sand (255-272)

Information upon completion of well:

(1) Diameter 2 inches.
(2) Total Depth 272 feet.
(3) Water Level 147 feet below top of ground.
(4) Cased to 262, Size 2
(5) Screen: Size 1/4, Length 6'
(6) Were any formations sealed against pollution?
yes, no.

If YES depth of formation
Why

Drillers Remarks:

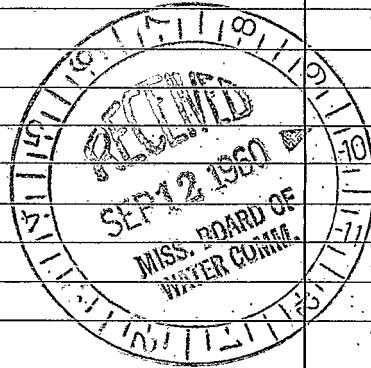

(Use Back Side)

Well No.

