

137 CODED
WATER WELL DRILLERS LOG

5 D6
5-12-61
Date: 5/17/61, 19___, Driller: F. K. MERRITT County WINSTON
(Name)

(1) Owner of Land: HOWARD GARNER
(Name)
LOUISVILLE, MISS
(Address)

(2) Location: ___ 1/4, ___ 1/4, Sec. 11 15 11 T. R. ___
6 miles N-W of LOUISVILLE
(distance) (direction) (Nearest Town)

(3) Topography: (Hilly) (Flat) (Level)

(4) Purpose of Well: Domestic
(Domestic Irrigation
Municipal, Industrial, Other)

Description & Color of Materials Sand, Clay, Red Clay, Shell, etc.	Thick- ness Feet	Depth Feet
<u>Orange clay</u>	<u>0</u>	<u>10</u>
<u>Dark Brown clay</u>	<u>10</u>	<u>17</u>
<u>Hard soapstone</u>	<u>17</u>	<u>26</u>
<u>Hard Lignite</u>	<u>26</u>	<u>28</u>
<u>Hard blue clay</u>	<u>28</u>	<u>67</u>
<u>Soft clay, trace of fine blue sand</u>	<u>67</u>	<u>72</u>
<u>Med. Hard grey clay</u>	<u>72</u>	<u>80</u>
<u>Soft light grey clay</u>	<u>80</u>	<u>91</u>
<u>Med. Hard grey clay, dark</u>		
<u>Med. soft dark clay</u>	<u>91</u>	<u>112</u>
<u>Soft lt. grey clay</u>	<u>112</u>	<u>141</u>
<u>Hard grey clay</u>	<u>141</u>	<u>145</u>
<u>2" Rock at 145"</u>		
<u>Soft grey clay, powder sand & shale</u>	<u>145</u>	<u>175</u>
<u>Hard grey clay</u>	<u>175</u>	<u>178</u>
<u>2" rock at 176</u>		
<u>Soft grey clay, powder sand</u>	<u>178</u>	<u>250</u>
<u>powder sand, trace of shale & clay</u>	<u>250</u>	<u>328</u>

Information upon completion of well:

(1) Diameter 2 inches.

(2) Total Depth 328 feet.

(3) Water Level 147' feet below top of ground.


(4) Cased to 294, Size ___

(5) Screen: Size 1/4, Length 6'

(6) Were any formations sealed against pollution?
___ yes, no.

If YES depth of formation _____
Why _____

Drillers Remarks: _____

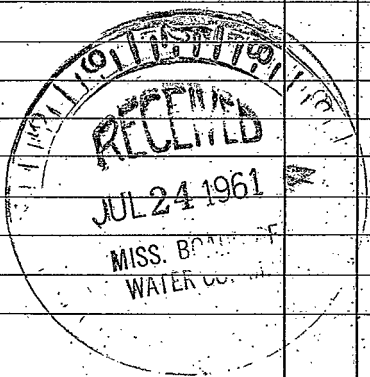

(Use Back Side)

Well No.

