

5 D8 137 CODED

WATER WELL DRILLERS LOG

5-25-64

Date: 5-25, 1964, Driller: ~~James~~ MERRITT County WINSTON
(Name Driller)

(1) Owner of Land: JAMES JOLLY
(Name)
Rt. 1, Louisville
(Address) 2 15 11

(2) Location: 1/4, 1/4, Sec. 13 T R
6 miles NW, of Louisville
(distance) (direction) (Nearest Town)

(3) Topography: Hilly
(Hilly) (Flat) (Level)

(4) Purpose of Well: Domestic
(Domestic Irrigation
Municipal, Industrial, Other)

Description & Color of Materials Sand, Clay, Red Clay, Shell, etc.	Thick- ness Feet	Depth Feet
Red CLAY	0	10
Grey CLAY	10	21
LIGNITE	21	23
Blue CLAY	25	45
LIGNITE	45	50
Blue CLAY	50	84
Blue CLAY + LIGNITE		
Mix'd with FINE SAND	84	158
FINE Blue SAND	150	210
COARSE Grey SAND	218	240

Information upon completion of well:

(1) Diameter 2" inches.

(2) Total Depth 240 feet.

(3) Water Level 147 feet below top of ground.

(4) Cased to 132', Size 2, ^{232 ft?}


(5) Screen: Size 2, Length 5'

(6) Were any formations sealed against pollution?
_____ yes, _____ no.

If YES depth of formation _____

Why _____

Drillers Remarks: _____

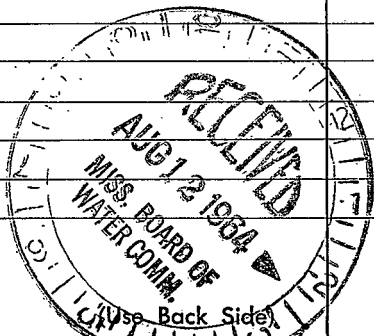

Well No. _____

Handwritten notes, possibly bleed-through from the reverse side of the page. The text is extremely faint and illegible.

Handwritten notes on the right side of the page, including the word "CPI" and other illegible characters.