

SD 9

135 WOOD

WATER WELL DRILLERS LOG

Date: Dec 3, 1964, Driller: MERRITT DRILLING CO County, WINSTON

(Name)

(1) Owner of Land: Troy Williamson
(Name)
 RT. 1 - Louisville, Miss
(Address)
 24-1511
 (2) Location: 1/4, 1/4, Sec. T R
 3 miles West of Louisville
(distance) (direction) (Nearest Town)
 (3) Topography: Hilly
(Hilly) (Flat) (Level)
 (4) Purpose of Well: IRRIGATION
(Domestic Irrigation) (Municipal, Industrial, Other)


Description & Color of Materials Sand, Clay, Red Clay, Shell, etc.	Thick- ness Feet	Depth Feet
Red CLAY	0	9
Yellow CLAY	9	14
Blue CLAY	14	62
Blue SAND	62	80
LIGNITE	80	82
Blue Gumbo	82	96
Green CLAY	96	100
HARD Grey SAND	100	105
FINE Blue SILT	105	126
Blue Gumbo	126	135
Blue SAND VERY FINE	135	256
Thin Rock		
Blue SAND & Shale	256	273

Information upon completion of well:

(1) Diameter 2 inches.
 (2) Total Depth 273 feet.
 (3) Water Level 104 feet below top of ground.
 (4) Cased to 135, Size 2"
 (5) Screen: Size Open, Length
 (6) Were any formations sealed against pollution?
 _____ yes, _____ no.

If YES depth of formation _____
 Why _____

Drillers Remarks:
 SHALE TRAP - SET AT
 135-FT.

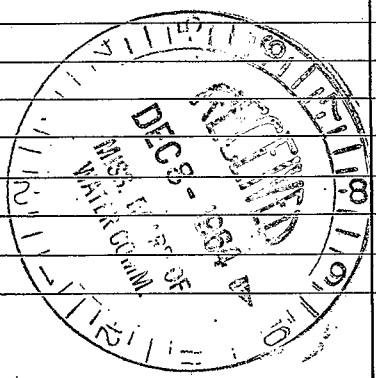

(Use Back Side)

Well No.

