

DIO

WATER WELL DRILLERS LOG

11-12-63

Date: 11-12, 1963, Driller: MERRITT DRILLING Co. WINSTON

(Name)

(1) Owner of Land: Billy Roberts

(Name)

Louisville, Miss

(Address)

12.15 11

(2) Location: 1/4, 1/4, Sec. 1 T. R.

5 miles North of Louisville

(distance)

(direction)

(Nearest Town)

(3) Topography: Hill

(Hilly)

(Flat)

(Level)

(4) Purpose of Well: Domestic

(Domestic Irrigation)

(Municipal, Industrial, Other)

Description & Color of Materials
Sand, Clay, Red Clay, Shell, etc.

Thick-
ness
Feet

Depth
Feet

Red CLAY

0

5

Blue CLAY

5

30

LIGNITE

30

32

Blue SAND & CLAY

32

42

Blue CLAY

49

64

ROCK

64

65

HARD Blue CLAY

65

81

GREEN CLAY

81

84

Blue CLAY

84

85

Blue CLAY & SAND

85

105

HARD Blue SAND &

CLAY

105

150

~~Blue~~ CLAY & LIGNITE

150

189

Blue CLAY

189

210

Blue SAND

210

232

Information upon completion of well:

(1) Diameter 2 inches.

(2) Total Depth 232 feet.

(3) Water Level 148 feet below top of ground.

(4) Cased to 168, Size 2

(5) Screen: Size , Length _____


(6) Were any formations sealed against pollution?

yes, no.

If YES depth of formation shale trap 168'

Why _____

Drillers Remarks: _____

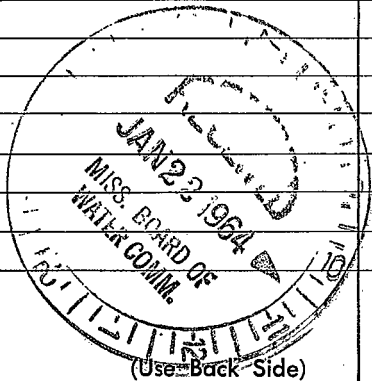

Well No.

[The page contains extremely faint and illegible text, likely due to low contrast or poor scan quality. The text is scattered across the page and does not form any recognizable words or sentences.]