

WINSTON

MISSISSIPPI BOARD OF WATER COMMISSIONERS

513T
COUED

E D 12

4-20-63

WATER WELL DRILLERS LOG

Date: 4-20, 1963, Driller: J. L. MERRITT County WINSTON
(Name)

	Description & Color of Materials Sand, Clay, Red Clay, Shell, etc.	Thick- ness Feet	Depth Feet
(1) Owner of Land: <u>Billie Bowie</u>	Red CLAY	0	20
(Name)	Lignite	20	21
<u>Louisville, Miss</u>	Blue CLAY	2	55
(Address)	Lignite	55	60
(2) Location: <u>3, 15 11</u>	FINE Blue SAND	60	62
Location: <u>1/4</u> , <u>1/4</u> , Sec. <u>1</u> T. <u>1</u> R. <u>1</u>	Blue clay & lignite	62	120
<u>5</u> miles <u>NORTH</u> of <u>Louisville</u>	Blue SAND	120	140
(distance), (direction), (Nearest Town)	Lignite -	140	147
(3) Topography: <u>Hilly</u>	TRACE OF SAND	147	165
(Hilly) (Flat) (Level)	GREEN CLAY	165	220
(4) Purpose of Well: <u>Domestic</u>	Blue SAND	220	253
(Domestic Irrigation, Municipal, Industrial, Other)			


Information upon completion of well:

- (1) Diameter 2 inches.
- (2) Total Depth 260 feet.
- (3) Water Level 147 feet below top of ground.
- (4) Cased to 147, Size 2
- (5) Screen: Size 1 1/4, Length 6'
- (6) Were any formations sealed against pollution?
 yes, no.

If YES depth of formation _____

Why _____

Drillers Remarks: _____

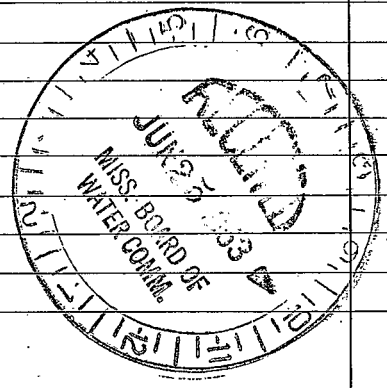

(Use Back Side)

Well No.

Handwritten text, mostly illegible due to fading and bleed-through. Some words like "and" and "the" are faintly visible.

Handwritten notes or a signature, possibly including the word "and" and some numbers.

Handwritten text at the bottom of the page, including what appears to be a date "1944" and some other illegible words.