

MISSISSIPPI BOARD OF WATER COMMISSIONERS

Winston  
3 D13  
10-66

136

CODED

WATER WELL DRILLERS LOG

Date: Oct.     , 1966, Driller: Layne-Central Co. County Winston  
(Name)

High Point Water Association

(1) Owner of Land: \_\_\_\_\_  
(Name)  
Louisville, Mississippi  
(Address)

(2) Location: NW 1/4, NE 1/4, Sec. 12 T 1 R 11E  
6 miles North of Louisville  
(distance) (direction) (Nearest Town)

(3) Topography: \_\_\_\_\_  
(Hilly) (Flat) (Level)

(4) Purpose of Well: Domestic  
(Domestic Irrigation  
Municipal, Industrial, Other)

Description & Color of Materials Sand, Clay, Red Clay, Shell, etc.	Thick- ness Feet	Depth Feet
Red Sandy Clay	8	8
Yellow Clay	12	20
Hard Blue Clay	88	108
Shale, stks. of lignite	92	200
Sandy Shale	67	267
Rock	2	269
Shale, stks. of lignite	14	283
Fine Sand, stks. of shale	31	314
Shale	71	385
Sand	27	412
Hard Shale	16	428

Information upon completion of well:

(1) Diameter 10 inches.

(2) Total Depth 416 feet.

(3) Water Level 173 feet below top of ground.


(4) Cased to 381', Size 10"

(5) Screen: Size 6", Length 25 ft.

(6) Were any formations sealed against pollution?  
 yes,  no.

If YES depth of formation 381'  
Why Required

Drillers Remarks: \_\_\_\_\_

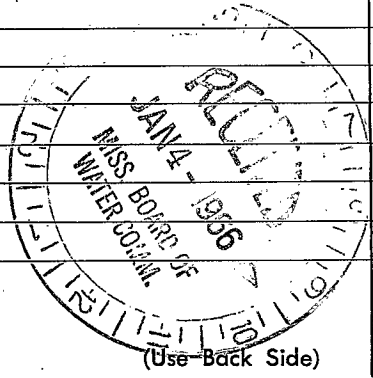

Well No.

(X)

1	...
2	...
