

WD 15 CODED 6 13T

3-10-66

WATER WELL DRILLERS LOG

Date: 3-10, 1966, Driller: MERRITT DRILLING CO County WINSTON  
 (Name)

(1) Owner of Land: John Hubert Dempsey  
 (Name)  
RT # 1 Louisville  
 (Address) 30-15-11

(2) Location: 1/4, 1/4, Sec. T R R  
12 miles WEST of Louisville  
 (distance) (direction) (Nearest Town)

(3) Topography: Hilly  
 (Hilly) (Flat) (Level)

(4) Purpose of Well: Domestic  
 (Domestic Irrigation  
 Municipal, Industrial, Other)

Description & Color of Materials Sand, Clay, Red Clay, Shell, etc.	Thick- ness Feet	Depth Feet
Red Clay	0	3
BUFF Clay	3	6
SAND Rock & clay	6	16
Fine white sand	16	19
Blue clay	17	25
Blue clay & sand	25	42
Brown clay & sand	42	70
TAN SAND	70	95
GRAY SAND	95	108

Information upon completion of well:

(1) Diameter 2 inches.

(2) Total Depth 108 feet.

(3) Water Level 30 feet below top of ground.


(4) Cased to 100, Size 2

(5) Screen: Size 1 1/4, Length 6'

(6) Were any formations sealed against pollution?  
 \_\_\_\_\_ yes,  no.

If YES depth of formation \_\_\_\_\_  
 Why \_\_\_\_\_

Drillers Remarks: \_\_\_\_\_

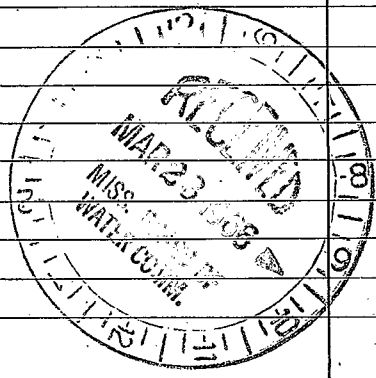

(Use Back Side)

Well No.

