

WD17
5-6-63

CODED 5 13T

WATER WELL DRILLERS LOG


Date: 5-6, 1963, Driller: J. L. Meariot County Winston
(Name)

(1) Owner of Land:	Description & Color of Materials Sand, Clay, Red Clay, Shell, etc.	Thick- ness Feet	Depth Feet
Charles Sissin (Name) Louisville, Miss (Address)	GRAY CLAY	0	10
2915 11	Blue CLAY	10	15
(2) Location: 1/4, 1/4, Sec. T. R.	LIGNITE	15	17
10 miles WEST of Louisville (distance) (direction) (Nearest Town)	CLAY & LIGNITE	17	19
(3) Topography: Hilly (Hilly) (Flat) (Level)	White CHALK	19	20
(4) Purpose of Well: DOMESTIC (Domestic Irrigation Municipal, Industrial, Other)	Blue CLAY	20	21
	LIGNITE	21	23
	Blue CLAY	23	42
	FINE PINK SAND	42	48
	WHITE SAND.	48	70

Information upon completion of well:

- (1) Diameter 2 inches.
- (2) Total Depth 70 feet.
- (3) Water Level 48 feet below top of ground.
- (4) Cased to 63, Size 2
- (5) Screen: Size 2", Length 5'
- (6) Were any formations sealed against pollution?
yes, no.

If YES depth of formation _____
Why _____
Drillers Remarks: _____

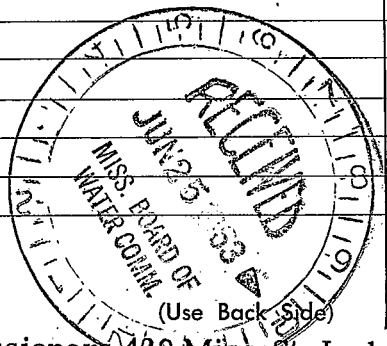

Well No.

1945

1946

1947

1959