

WINSTON  
 D18

MISSISSIPPI BOARD OF WATER COMMISSIONERS

CODED

6 135

WATER WELL DRILLERS LOG

Date: 11-11, 1963, Driller: Merritt Drilling Co. County: WINSTON

(Name)

(1) Owner of Land: W.A. Dempsey  
 (Name)  
Rfd. Louisville, Miss  
 (Address) 19 1511

(2) Location: 1/4, 1/4, Sec. 1, T. R,  
10 miles west, of Louisville,  
 (distance) (direction) (Nearest Town)

(3) Topography: Hilly  
 (Hilly) (Flat) (Level)

(4) Purpose of Well: Domestic  
 (Domestic Irrigation  
 Municipal, Industrial, Other)

Description & Color of Materials Sand, Clay, Red Clay, Shell, etc.	Thick- ness Feet	Depth Feet
<u>CLAY</u>	<u>0</u>	<u>3</u>
<u>RED SAND</u>	<u>3</u>	<u>10</u>
<u>WHITE SAND</u>	<u>10</u>	<u>40</u>
<u>Blue CLAY</u>	<u>40</u>	<u>50</u>
<u>YELLOW SAND</u>	<u>50</u>	<u>86</u>

Information upon completion of well:

(1) Diameter 2 inches.

(2) Total Depth 86' feet.

(3) Water Level 48' feet below top of ground.

(4) Cased to 80', Size 2"


(5) Screen: Size 2", Length 6'

(6) Were any formations sealed against pollution?  
 yes,  no.

If YES depth of formation \_\_\_\_\_

Why \_\_\_\_\_

Drillers Remarks: \_\_\_\_\_

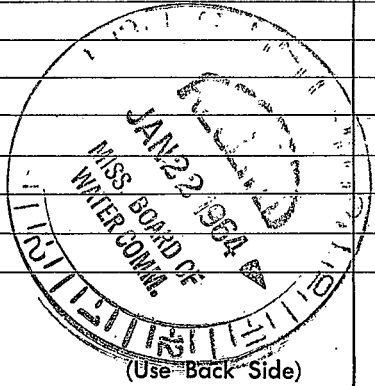

Well No. \_\_\_\_\_

